


MICROFILMED

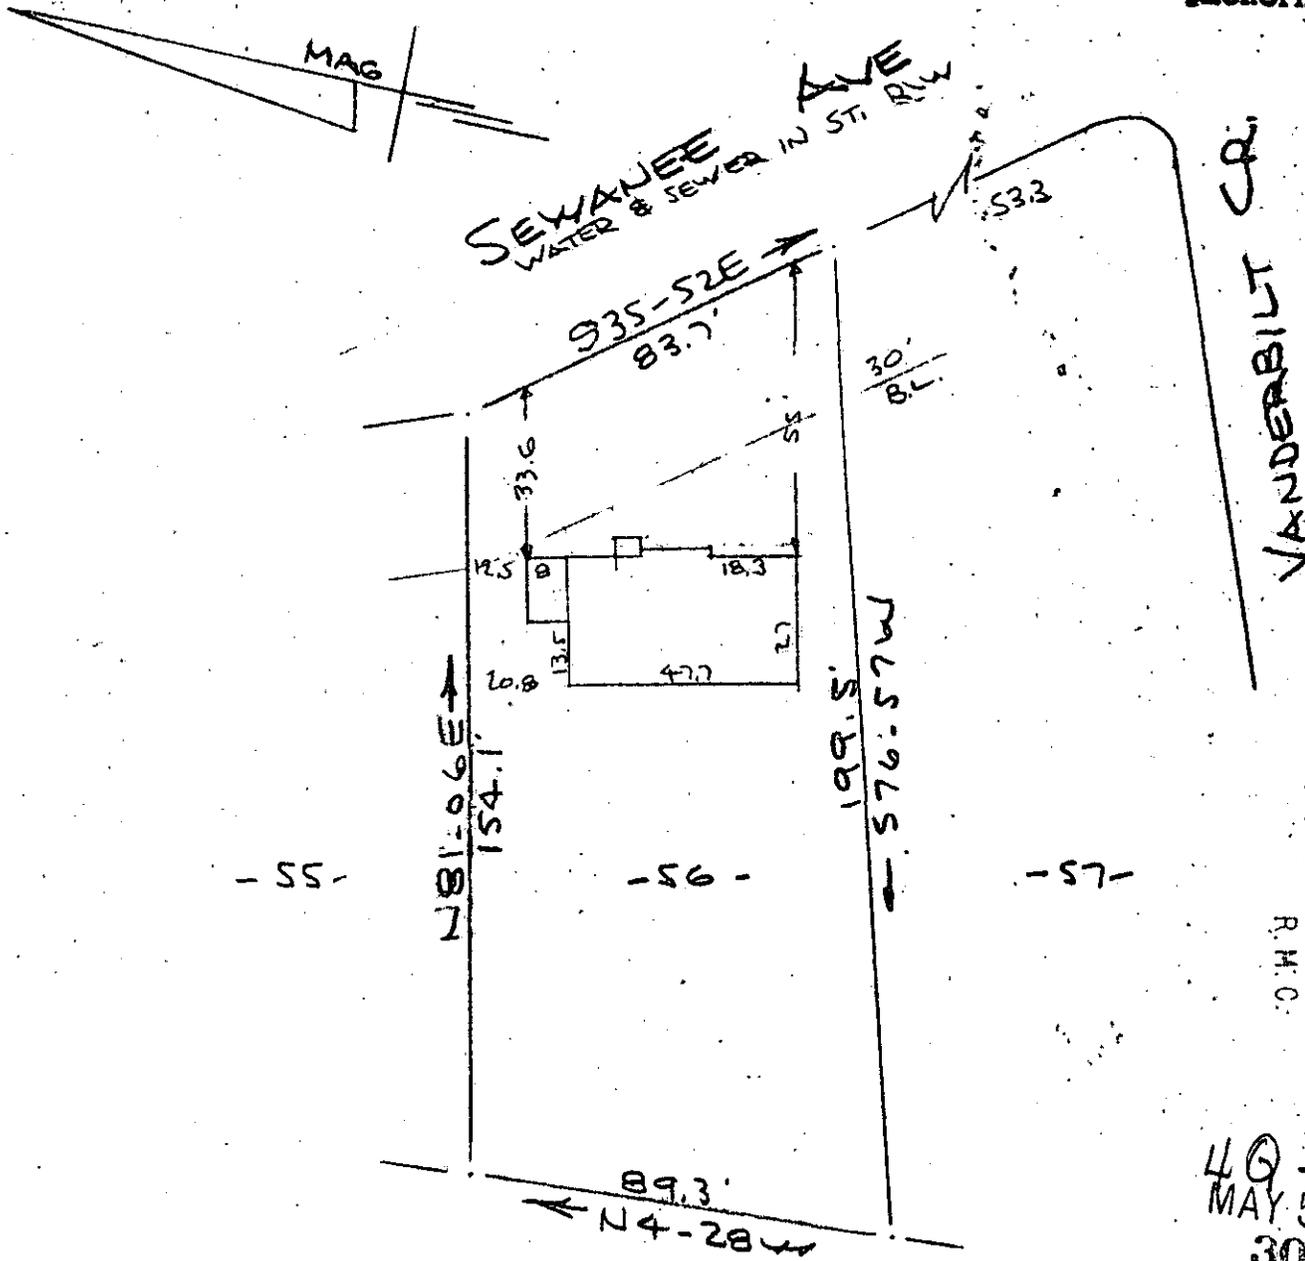

FILED
 GREENVILLE CO. S.C.
 MAY 5 2 06 PM '72
 OLLIE FARNSWORTH
 R.M.C.

40-61 ✓
 MAY 5 - 1972
 30067

RECORDING FEE
 PAID \$ 1.00

PROPERTY OF
FRANCIS GENE FOWLER
 NEAR GREENVILLE, S.C.
 SCALE: 1" = 40' 27 APR 1972

This is to certify that on the 27th day of April 1972, I surveyed the property shown on this plat, being known as lot 56 on plat of WHITE OAK SUBDIVISION and recorded in the RMC Office Greenville County, S.C., in Plat Book "P" at Page 121; and that the property lines, walls and buildings are as shown hereon, and that the walls and buildings located on said lot do not encroach or project on adjacent street or property, and that no adjacent walls or buildings encroach or project on said premises, and no power lines cross this property except as shown hereon. And also known as PROPERTY OF FRANCIS GENE FOWLER and recorded in Plat Book at Page

R. B. Bruce
 R. B. Bruce, RLS #1952

CAROLINA SURVEYING COMPANY
 112 Manly Street

40-61

2/63

Greenville, S. C.