


49 / 93

MICROFILMED

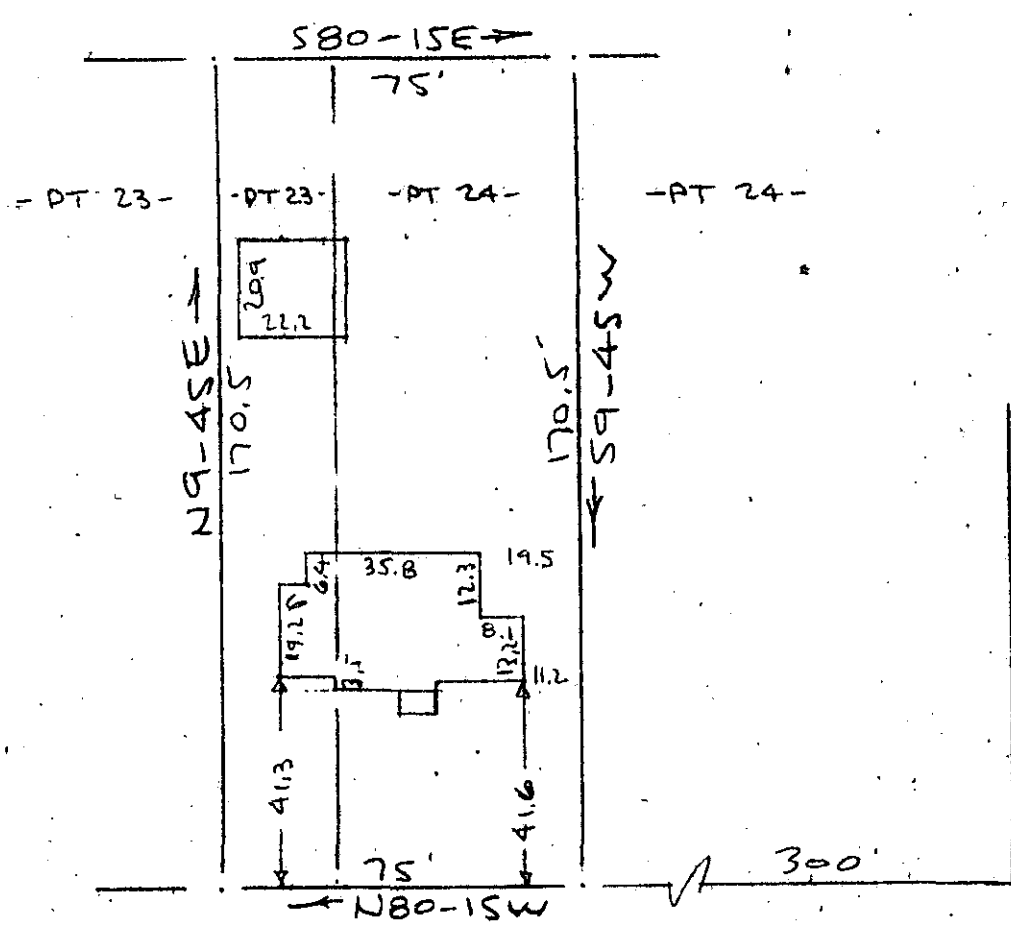

BUIST AVE
WATER & SEWER IN ST. RW.

PROPERTY OF
FRANKLIN CURTIS ALLEN & CLAUDIA W. ALLEN
 GREENVILLE, S. C.
 SCALE: 1" = 40' 25 MAY 1972

This is to certify that on the 25th day of May 1972, I surveyed the property shown on this plat, being known as portions of lots 23 & 24 on plat of SECTION B OAKLAND HEIGHTS and recorded in the RMC Office Greenville County, S.C., in Plat Book "F" at Page 204; and that the property lines, walls and buildings are as shown hereon, and that the walls and buildings located on said lots do not encroach or project on adjacent street or property, and that no adjacent walls or buildings encroach or project on said premises, and no power lines cross this property except as shown hereon.

B. B. Bruce
 R. B. Bruce, RLS #1952

MAY 29 1972

32390

RECORDING FEE
 PAID \$ 1.00

CAROLINA SURVEYING COMPANY
 112 Manly Street

49 - 93

116/24

Greenville, S. C.

FILED
 GREENVILLE CO. S. C.
 MAY 29 11 20 AM '72
 OLLIE FARNSWORTH
 R. M. C.