



026X52

OWNERS

JOHN W MADISON AND  
ELEANOR G MADISON  
MARIETTA, S.C.

NOTE: ALL LOTS FROM LOT # 21 TO # 28 (incl) Changed Aug 8, 1972  
115 feet on North Saluda Drive front  
And 155 feet depth as now shown on plat.

DR # MRS A. P. DUFF

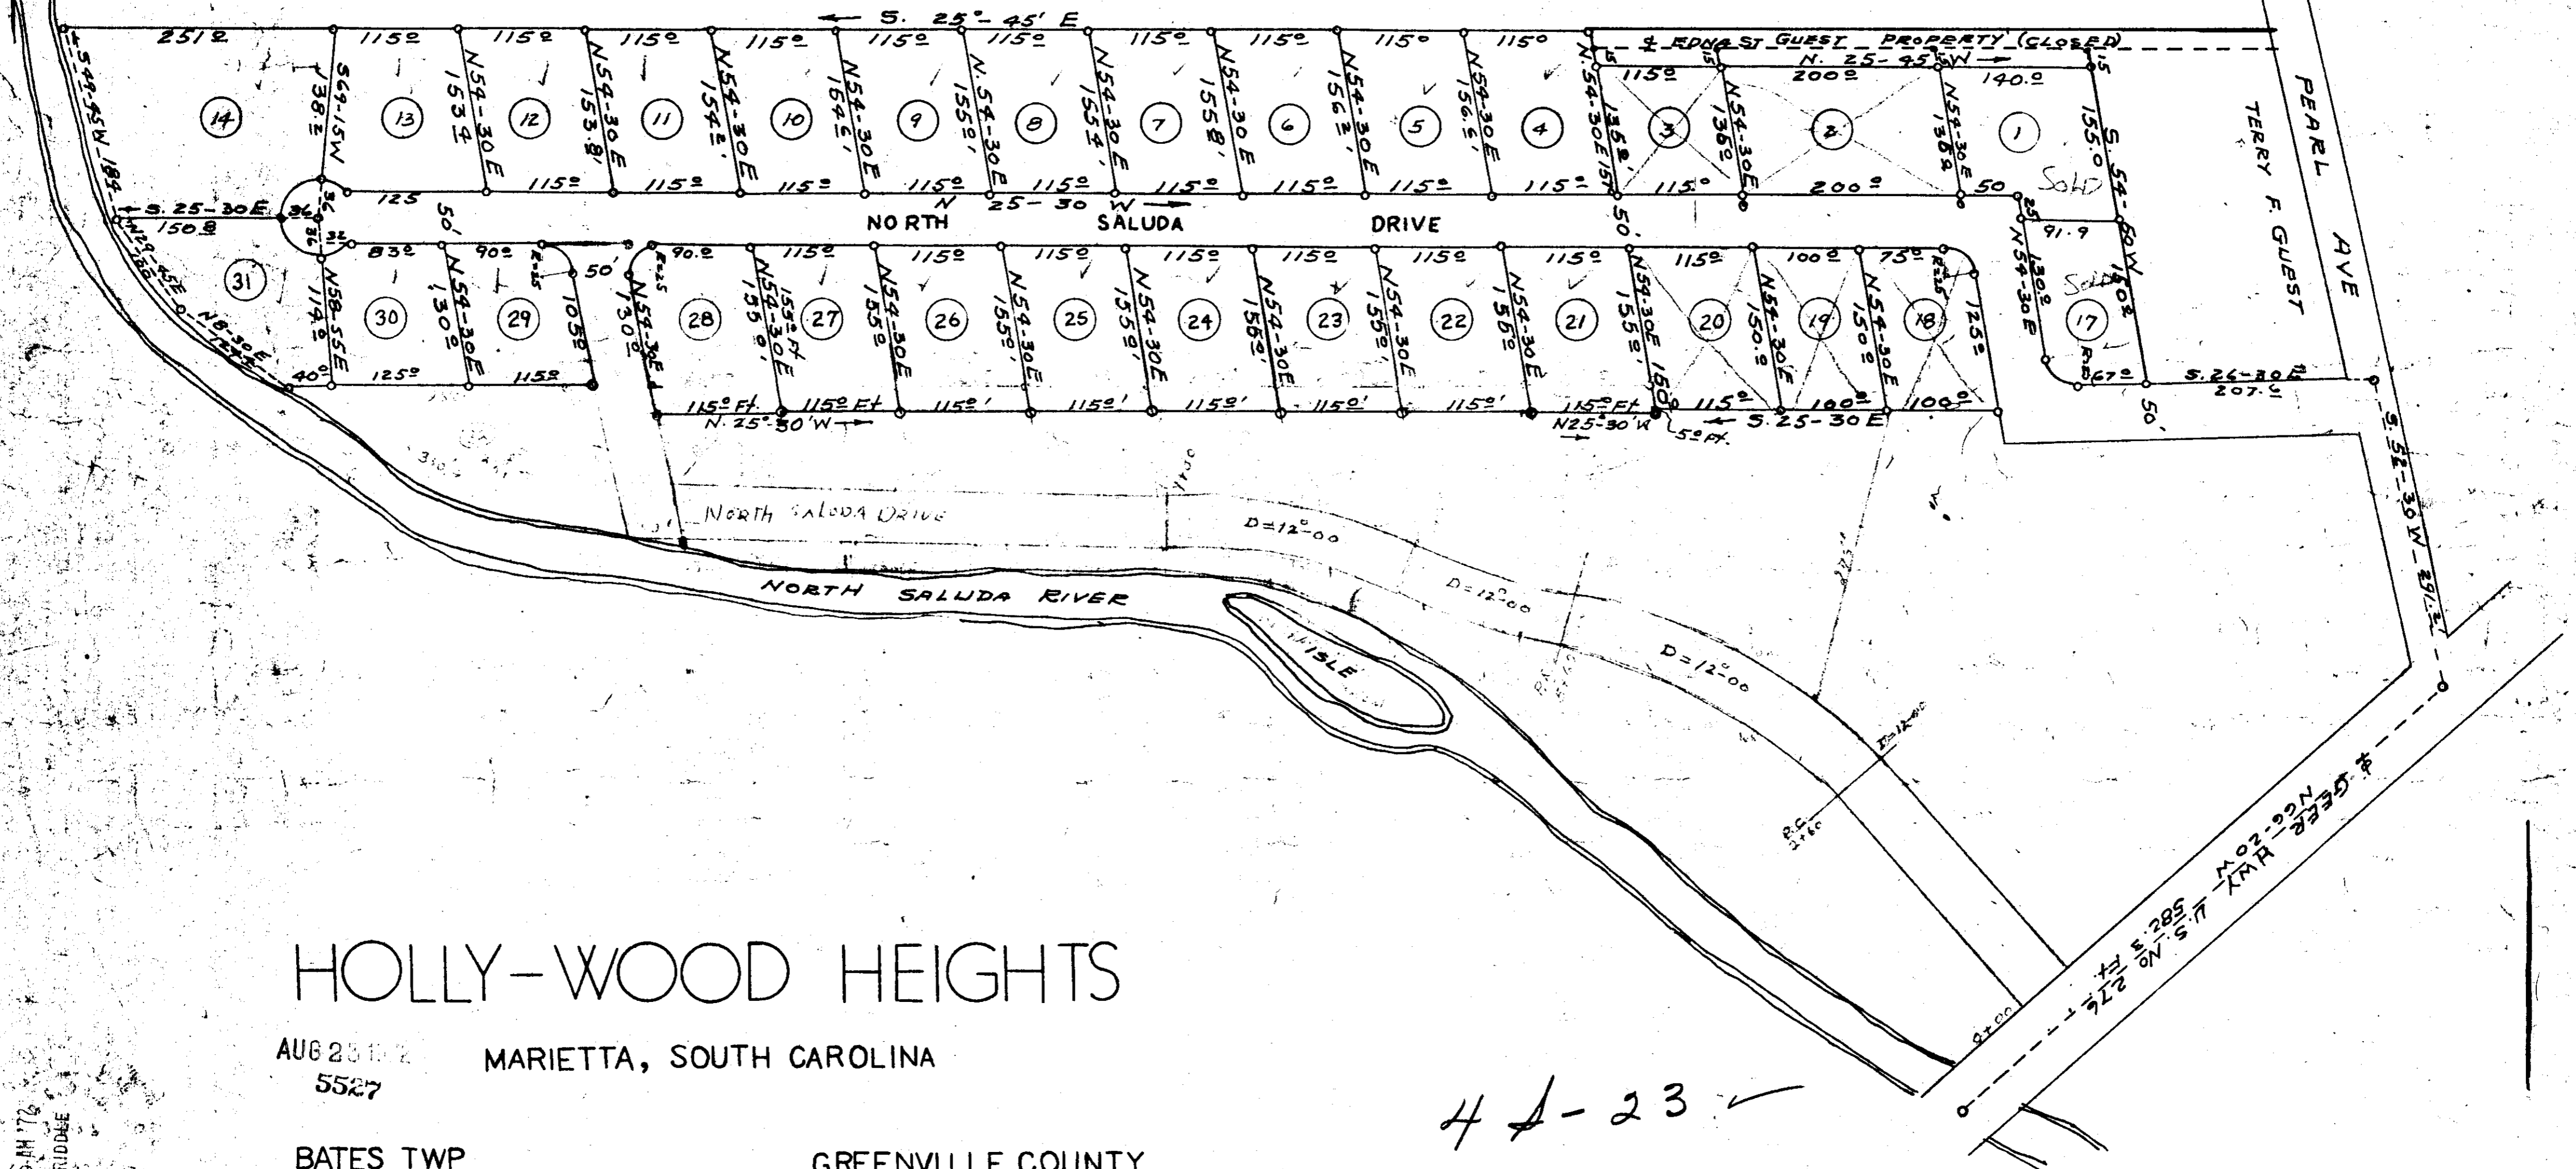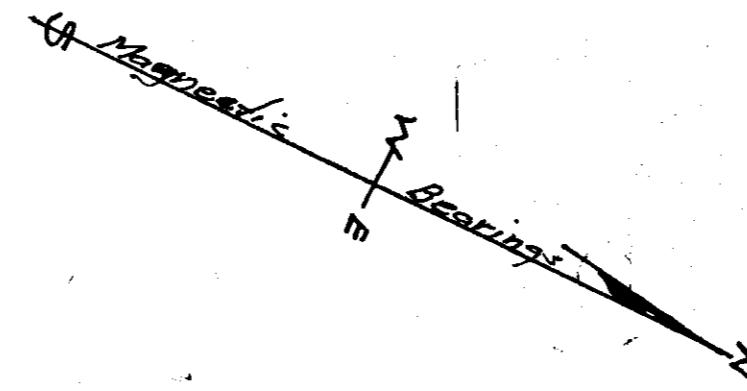

# HOLLY-WOOD HEIGHTS

AUG 25 1972 MARIETTA, SOUTH CAROLINA  
5527

BATES TWP

GREENVILLE COUNTY

44-23

FILED  
GREENVILLE CO. S.C.  
AUG 23 9 50 AM '72  
ELIZABETH RIDDLE  
R.M.C.

SURVEY JULY 1963  
BY Terry T. Dill  
C.E. & L.S. NO. 104 /39  
R#2 Dill Road #23489  
Taylors, S.C. 29687

SCALE 1"=100'