


FILED  
GREENVILLE CO. S.C.  
AUG 15 4 57 PM '72  
ELIZABETH RIDDLE  
R.M.C.

WESTMORELAND  
CIRCLE

FILED  
GREENVILLE CO. S.C.  
AUG 15 4 20 PM '72  
ELIZABETH RIDDLE  
R.M.C.

Old I.P. at 141.5'

JONES  
Old I.P. N. 10° 52' E  
60.7'

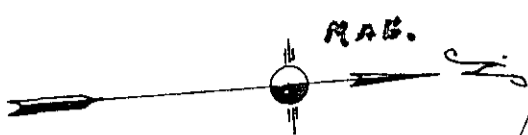

0.26 ACRE

0.60 ACRE

Right of way line  
5.32° 56' E  
121.7'

PINE STREET

124.8'  
New Line  
N. 4° 05' E  
115.7'  
New I.P.  
136'  
Right of way line  
S. 85° 27' E  
280.8' Total

U.S. SUPER HIGHWAY # 29 (Northbound lane)

Note: Plat amended Aug 4 1972  
to show New Line.



PROPERTY OF  
JAMES A. BLACK JR.

Located in Greer.  
BLACK SPRINGS TOWNSHIP GREENVILLE COUNTY.  
SOUTH CAROLINA

SCALE: 1" = 50 FEET.

SEPT. 17, 1960.

Survey made Sept 12, 1960.

RECORDING FEE  
PAID \$ 1.00

Note: The above plat shows the amendments to  
property described in deed, recorded in Vol. 834  
page 355, also on plat of Mrs. J.C. Cunningham  
property made by H.S. Brockman, May 19 1953.

46-61 ✓  
John A. Simmons - Reg. Surveyor # 2212  
GREER, S.C.

4635

AUG 15 1972