FED. ROAD DIST. No.	STATE	FEDERAL PROJ. NO.	FISCAL YEAR	SHEET No.	TOTAL SHEETS

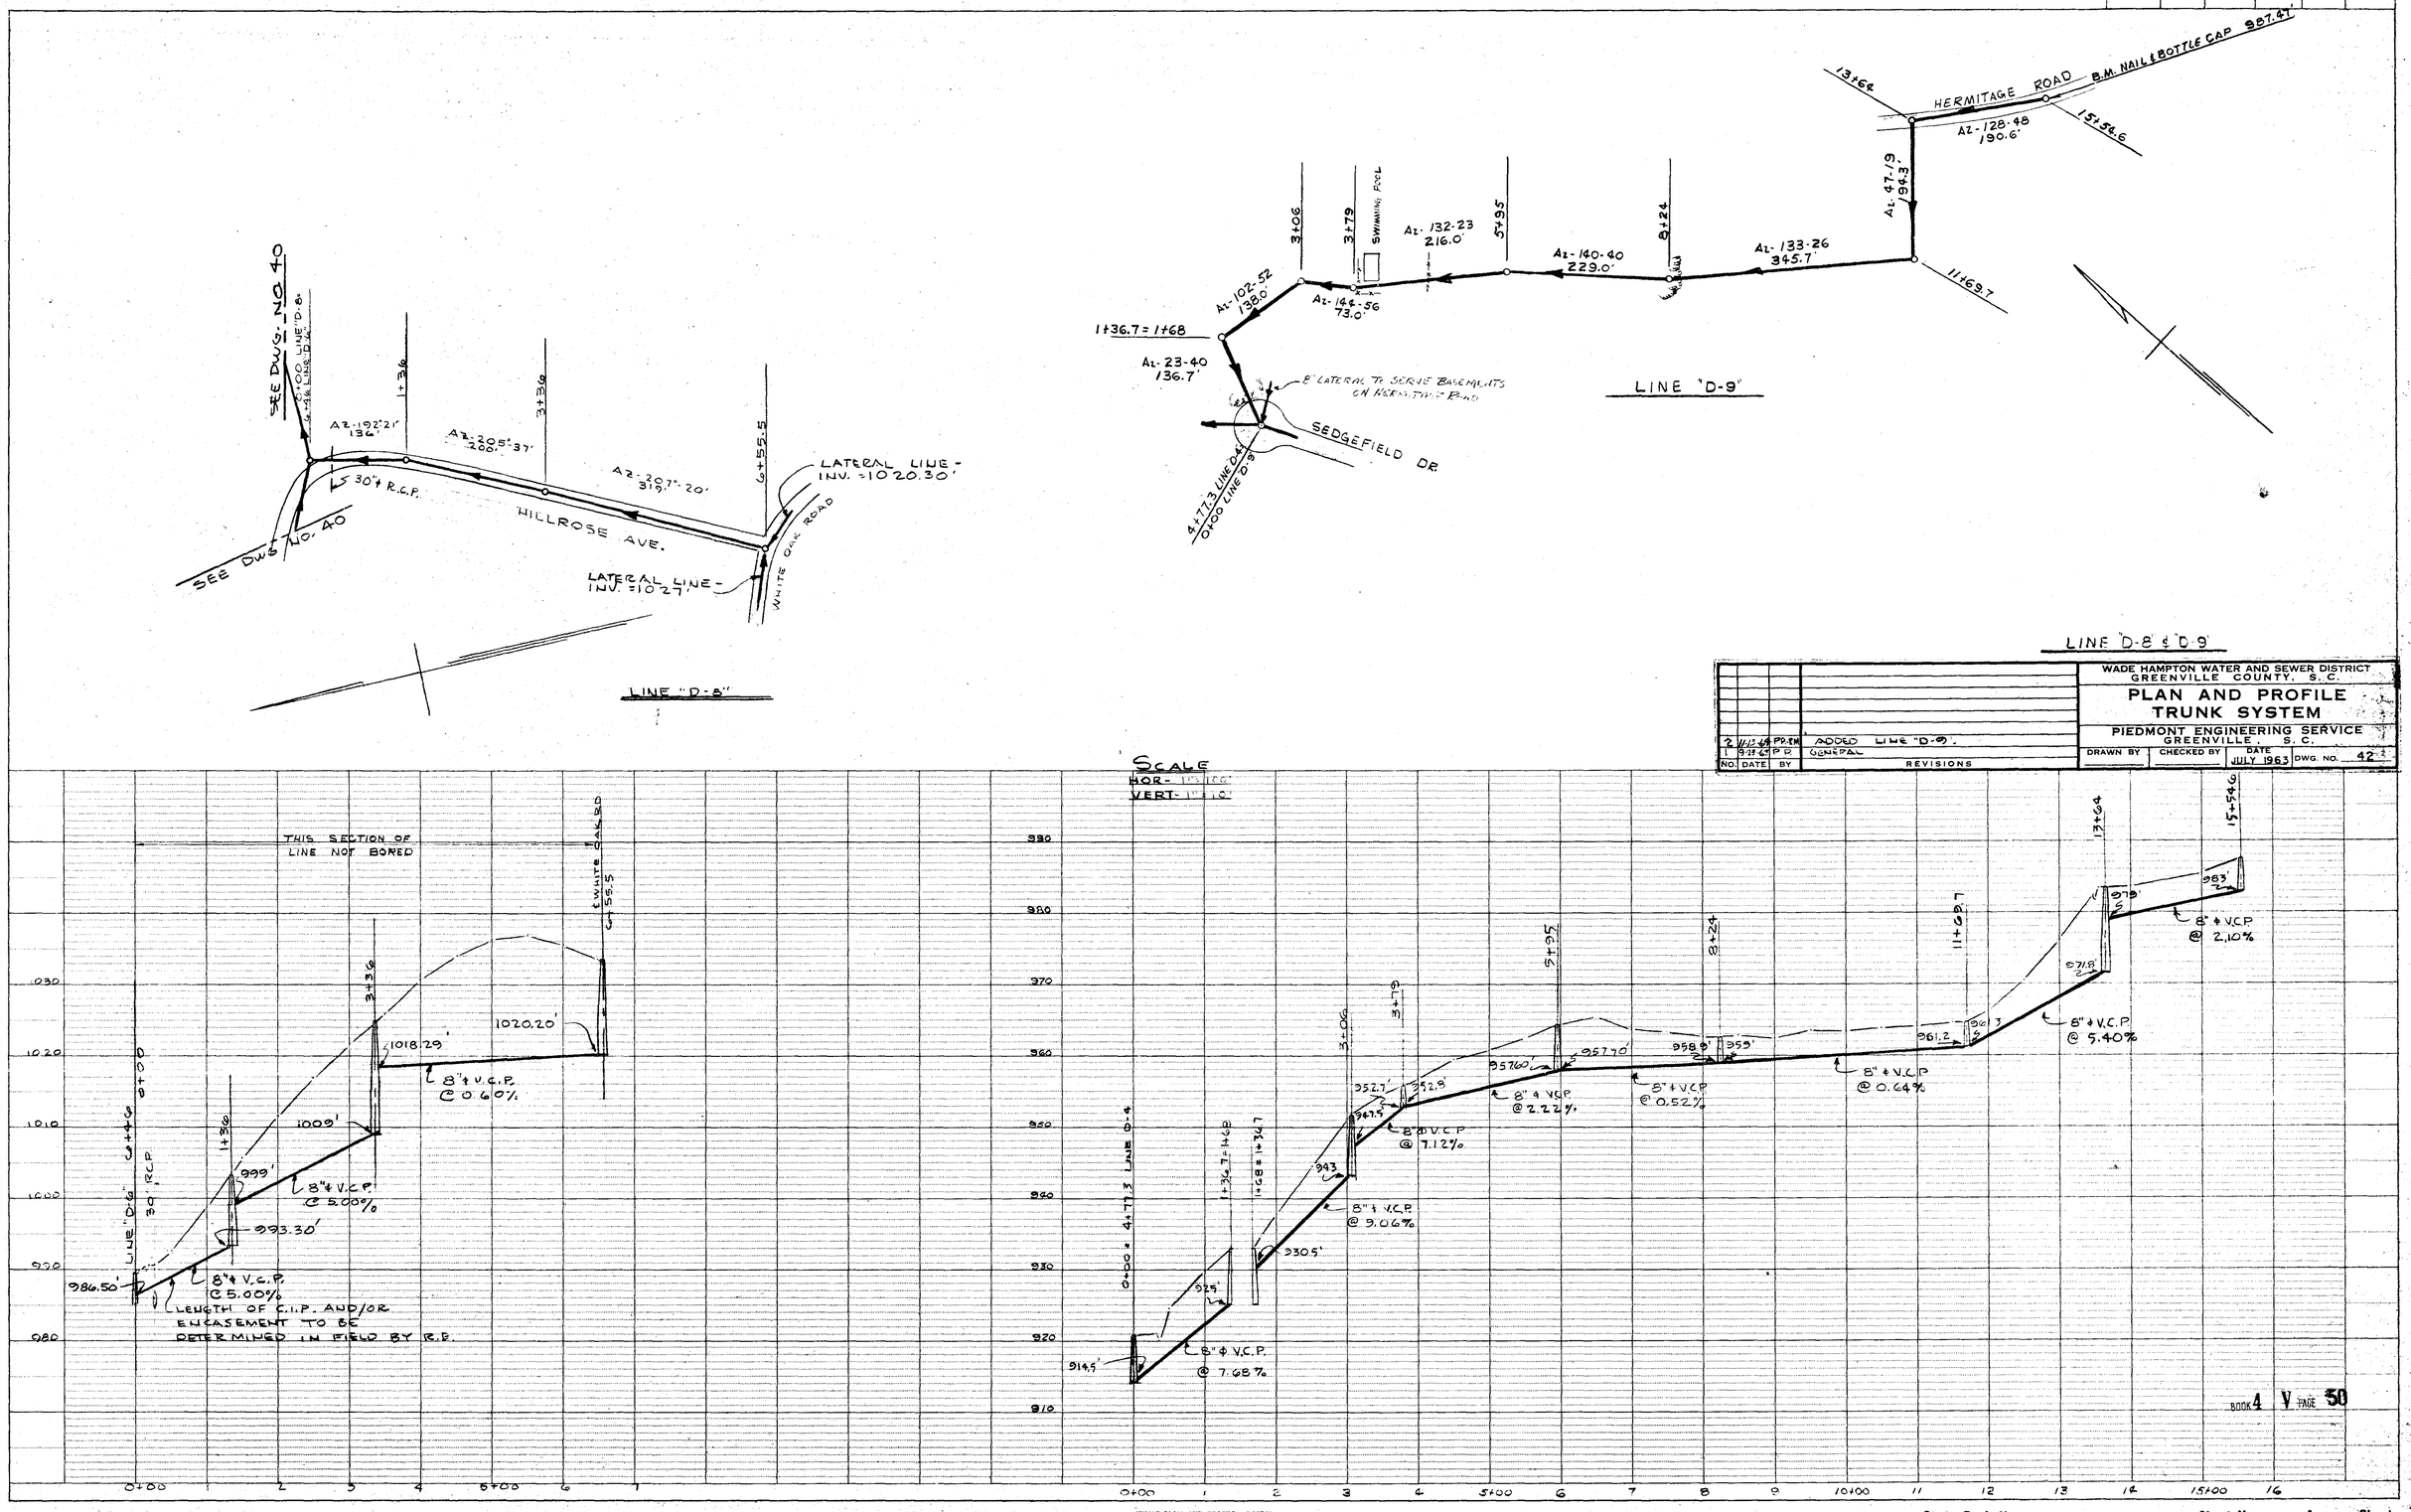

NO.	DATE	BY	REVISIONS
2	11-13-63	P.D.R.M.	ADDED LINE "D-9".
1	9-23-63	P.D.	GENERAL

WADE HAMPTON WATER AND SEWER DISTRICT
GREENVILLE COUNTY, S. C.

PLAN AND PROFILE
TRUNK SYSTEM

PIEDMONT ENGINEERING SERVICE
GREENVILLE, S. C.

DRAWN BY	CHECKED BY	DATE	DWG. NO.
		JULY 1963	42

PLAN: SURVEYED ___ PLOTTED ___ ALIGNMENT CHECKED ___ R/W OF WAY CHECKED ___ NOTE BOOK NO. ___ BY ___ DATE ___

PROFILE: SURVEYED ___ PLOTTED ___ GRADES CHECKED ___ B.M.'s NOTED ___ STRUCTURE NOTATIONS CHKD ___ NOTE BOOK NO. ___ BY ___ DATE ___

BOOK 4 V PAGE 50

SINGLE PLAN AND PROFILE — DOTTED
H. A. ROGERS CO. - MINNEAPOLIS - ST. PAUL - DULUTH

State Proj. No. ..... Sheet No. ..... of ..... Sheets