


PROFILES
EAST LAGOON DRAINAGE AREA

FINAL SURVEY	DATE
BURNED	BY
PLOTTED	
ROUTE BOOK	
AREAS CHECKED	
NO. 3, 26, 27, 28	

ORIGINAL SURVEY	DATE
BURNED	BY
PLOTTED	
ROUTE BOOK	
AREAS CHECKED	
NO. 3, 26, 27, 28	

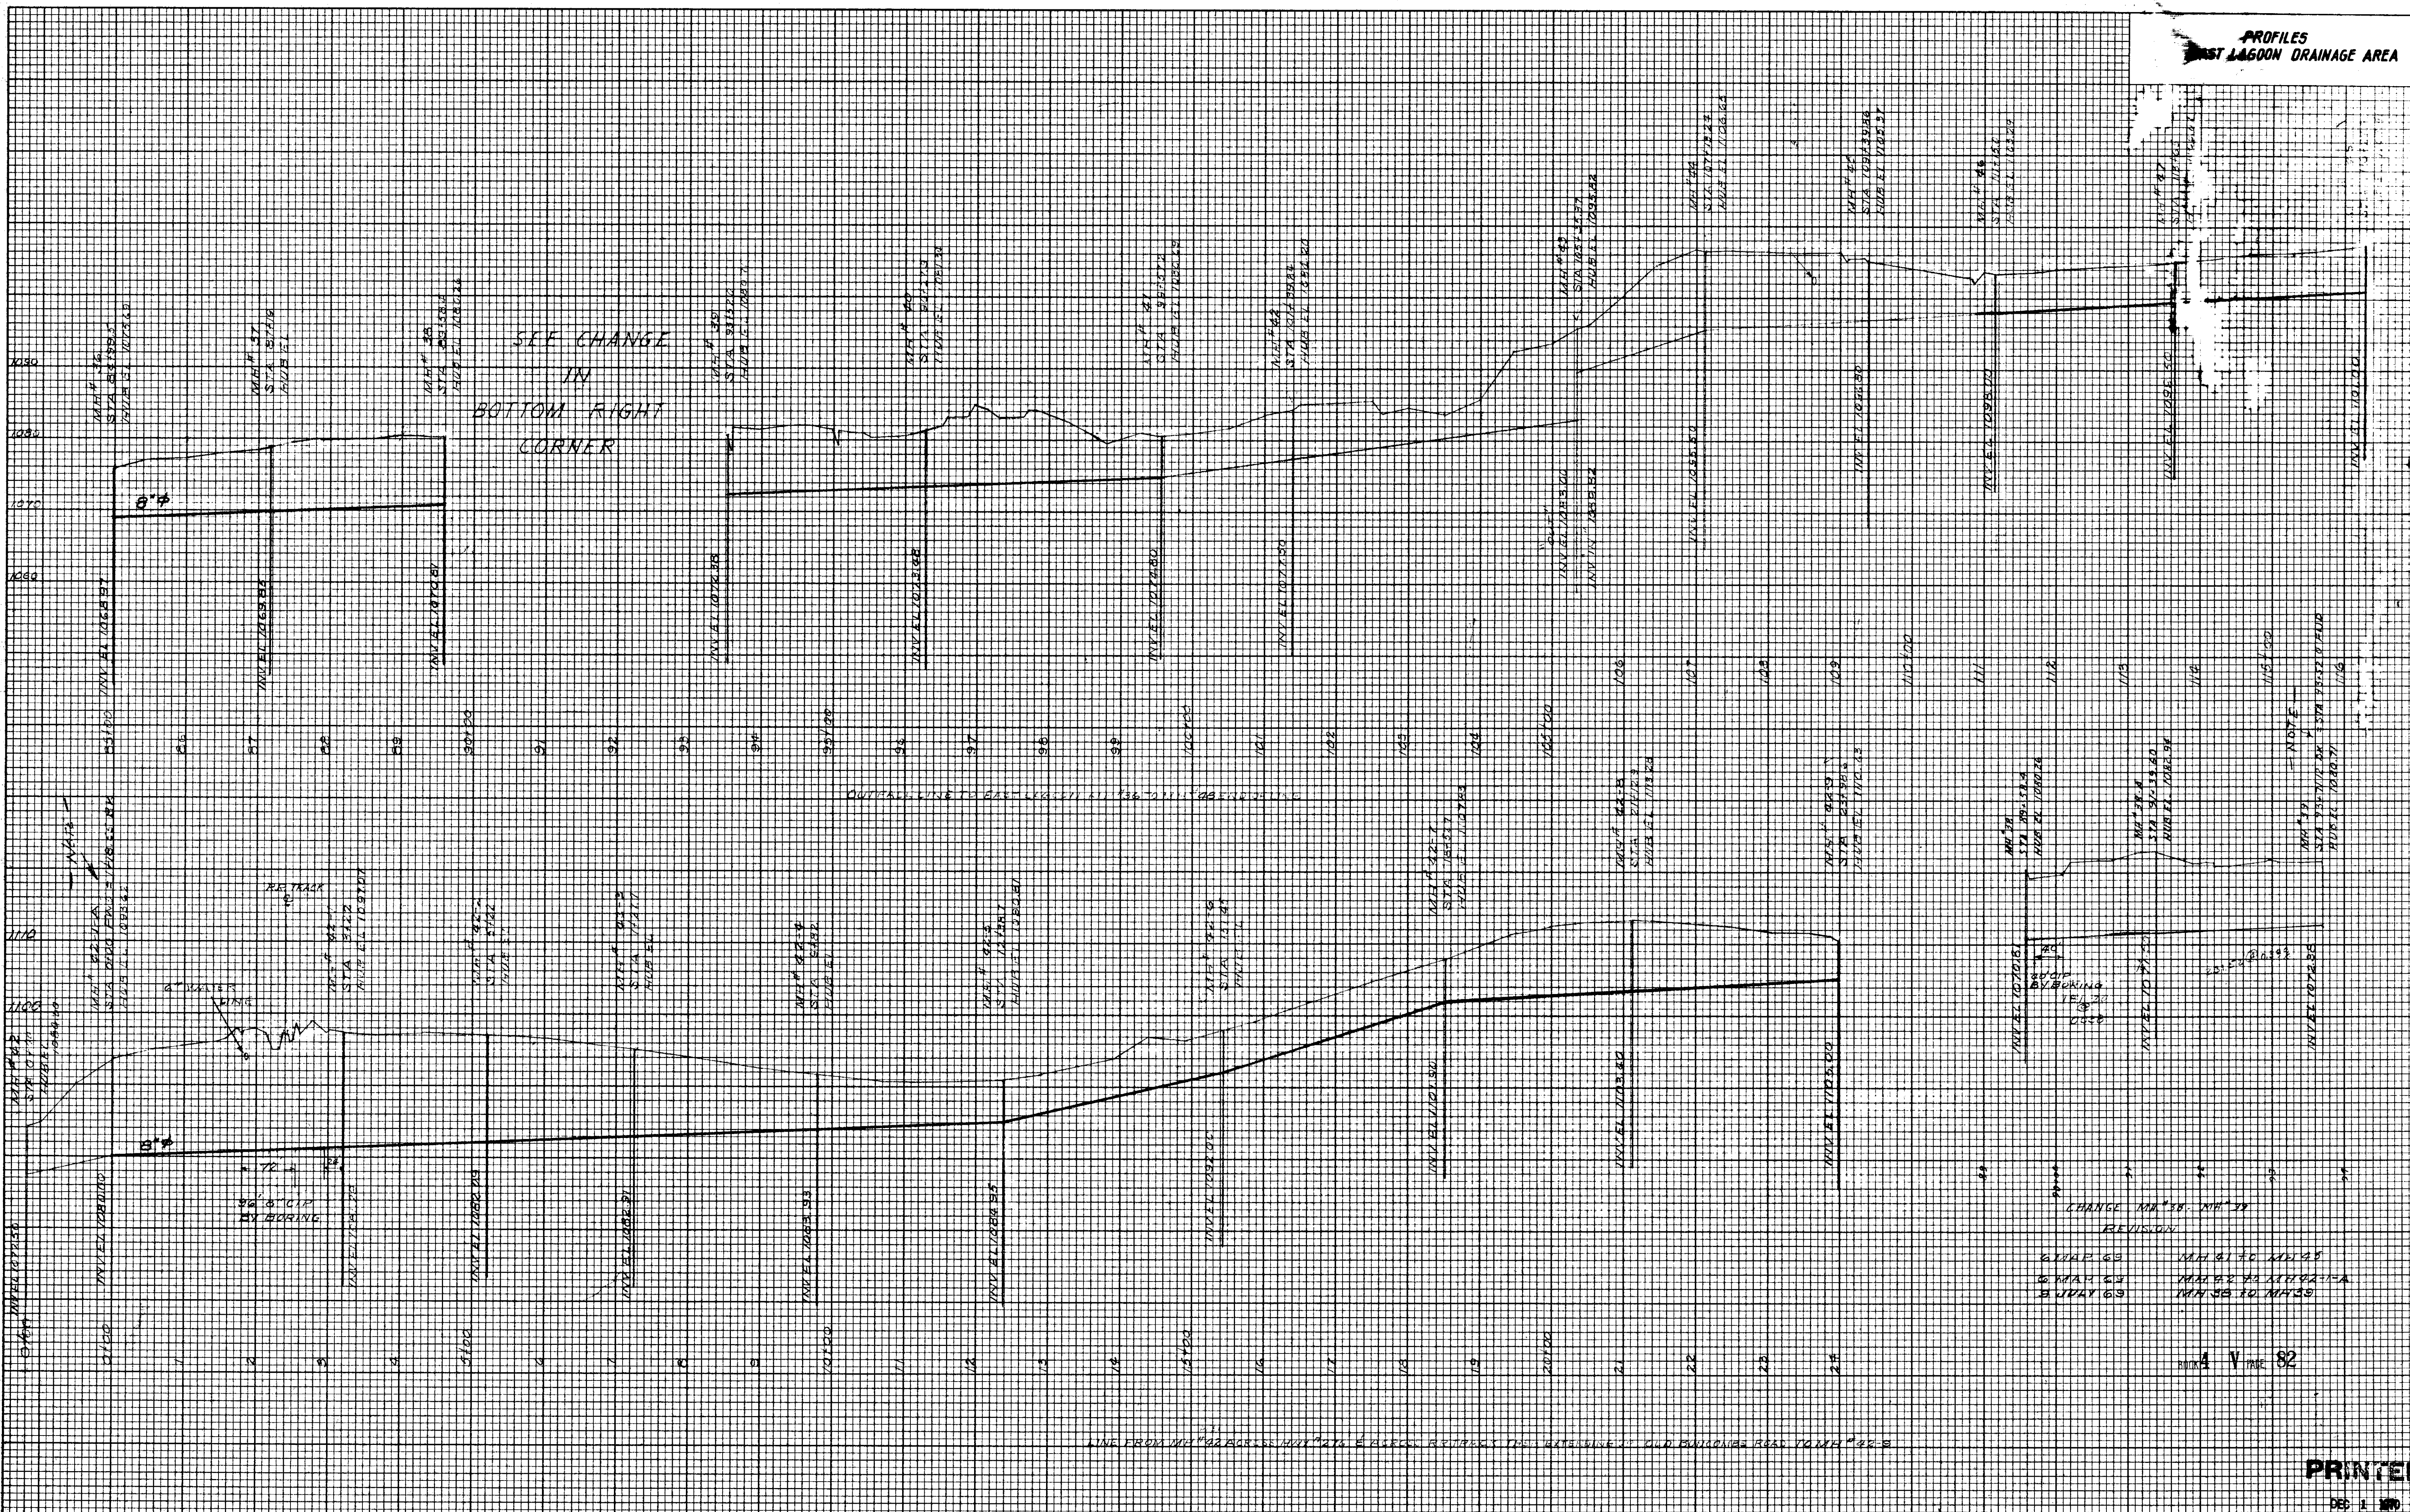

REVISION:

CHANGE MA 28, MA 29	MA 28 TO MA 29
6 MAY 63	MA 29 TO MA 30
3 JULY 63	MA 30 TO MA 31