

Block Book No.	Name	Length of Sewer Thru Prop.	Length of R/W Thru Prop.	M.H.
B4.5-1-6	Willie W. Bynum	85'	145'	1
B4.5-1-6.2	Harold B. Kay	100'	120'	1
B4.5-1-7	Carl F. Bynum Jr.	85'	130'	1
B4.5-1-8	Kathryn B. Johnson	141'	145'	2
B4.5-1-9	Elizabeth H. Lather	525'	555'	4
B4.5-1-10	Eliza S. Bynum	635'	650'	4
B4.5-1-11	George E. & Winnie H. Williams	795'	820'	1
B4.5-1-12	J.J. & Azalee B. Burdine	100'	100'	0
B4.5-1-13	P.W. Burdine	200'	205'	0
B4.5-1-13.3	Samuel P. & Wayne B. Gaines	90'	90'	0
B4.5-1-13.4	Marquerite Lee Burdine (Etal)	83'	83'	1
B4.5-1-15	J.T. Burdine Jr.	15'	30'	1

Block Book #	Name	Length of Sewer Thru Prop.	Length of R/W Thru Prop.	M.H.
B.4.5-1-5	C.J. Bowen	165'	165'	1
B.4.5-1-5.1	Lisle S. & Bonnie S. Tyler	130'	130'	0
B.4.5-1-5.2	Hubert & Margaret Grover	145'	145'	0
B.4.5-1-6	Willie W. Bynum	0'	210'	0
B.4.5-1-9.1	Bruce L. & Moise D. Smith	1200'	1250'	8
B.4.5-1-10	Eliza S. Bynum	130'	190'	2
B.4.5-1-11	George E. & Winnie H. Williams	370'	370'	3
B.4.5-1-13	P.W. Burdine	570'	580'	4
B.4.5-1-15	J.T. Burdine Jr.	10'	50'	1
B.4.5-1-6.2	Harold B. Kay	0'	110'	0

B-4.3

B-15


B-4.4

B-13



GREENVILLE CO. S.C.
 FILED
 1975 MAR 19 10 11 AM
 GEORGE S. TRENKLE
 REC'D

21172 Berea Public Service District Commission
 BOOK 4 V. PAGE 204

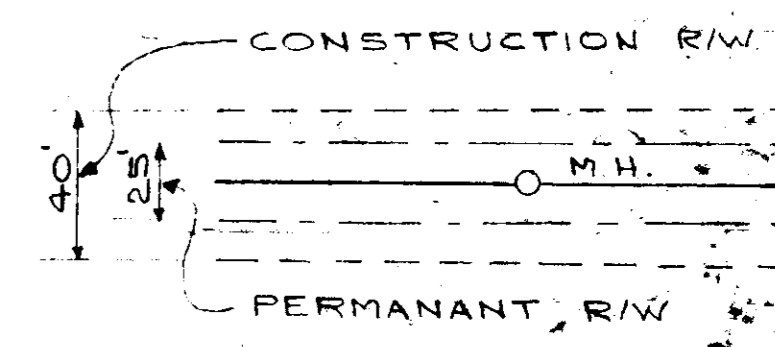

LEGEND

RELEASED-7-23-75
 RE RELEASED-8-7-75
 RE RELEASED-9-12-75
 RE RELEASED-11-25-75
 11 13-14-77

MICROFILMED

REVISIONS	NO	DATE	BY
4	11-25	BP	REMOVED SOME OF LINE ON FRONT LOT LOTS 10 & 11
5	3-11-77	BP	RELOCATED LINE ON LOT 11

PIEDMONT, ENGINEERS & ARCHITECTS

SHEET 4-0

GREATER GREENVILLE TAX MAPS
 GREENVILLE, S.C.

TAX DISTRICT 305 NUMBER B4.5 PREVIOUS

B4.5

SCALE 1" = 200' INDEX 13

Filed This 14th day of March 1975
 And Recorded in Vol. 47 Page 204
 Register Meigs Conveyance Greenville County, S.C.