


RECORDING FEE
PAID \$ *100*

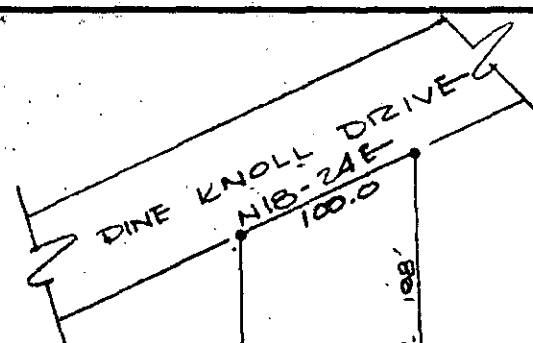

LINDSAY

N47-53W


605.3



S48-34E

647.2

M. RAY BRACKEN

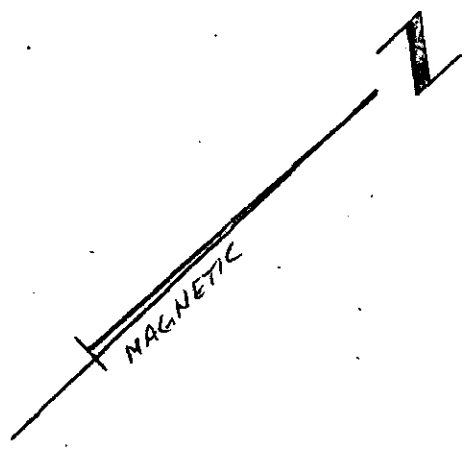

FILED
GREENVILLE CO. S. C.
MAR 16 4 58 PM '73
DONNIE S. TANKERSLEY
R.M.C.

100
S43-08W

✓
44-96

U. S. HIGHWAY NO. 29

26079

ROBERT R. SPEARMAN
Registered Surveyor 3615
Post Office Box 6
Easley, South Carolina 29640



TITLE
PROPERTY OF JAMES
C. KING JR. SHOWING
BUILDING ENCROACHMENT

STATE S.C. COUNTY GREENVILLE

SCALE 1"=100 DATE MAR 14, 1973 REF. NO.