



RECORDING FEE
PAID \$ 100

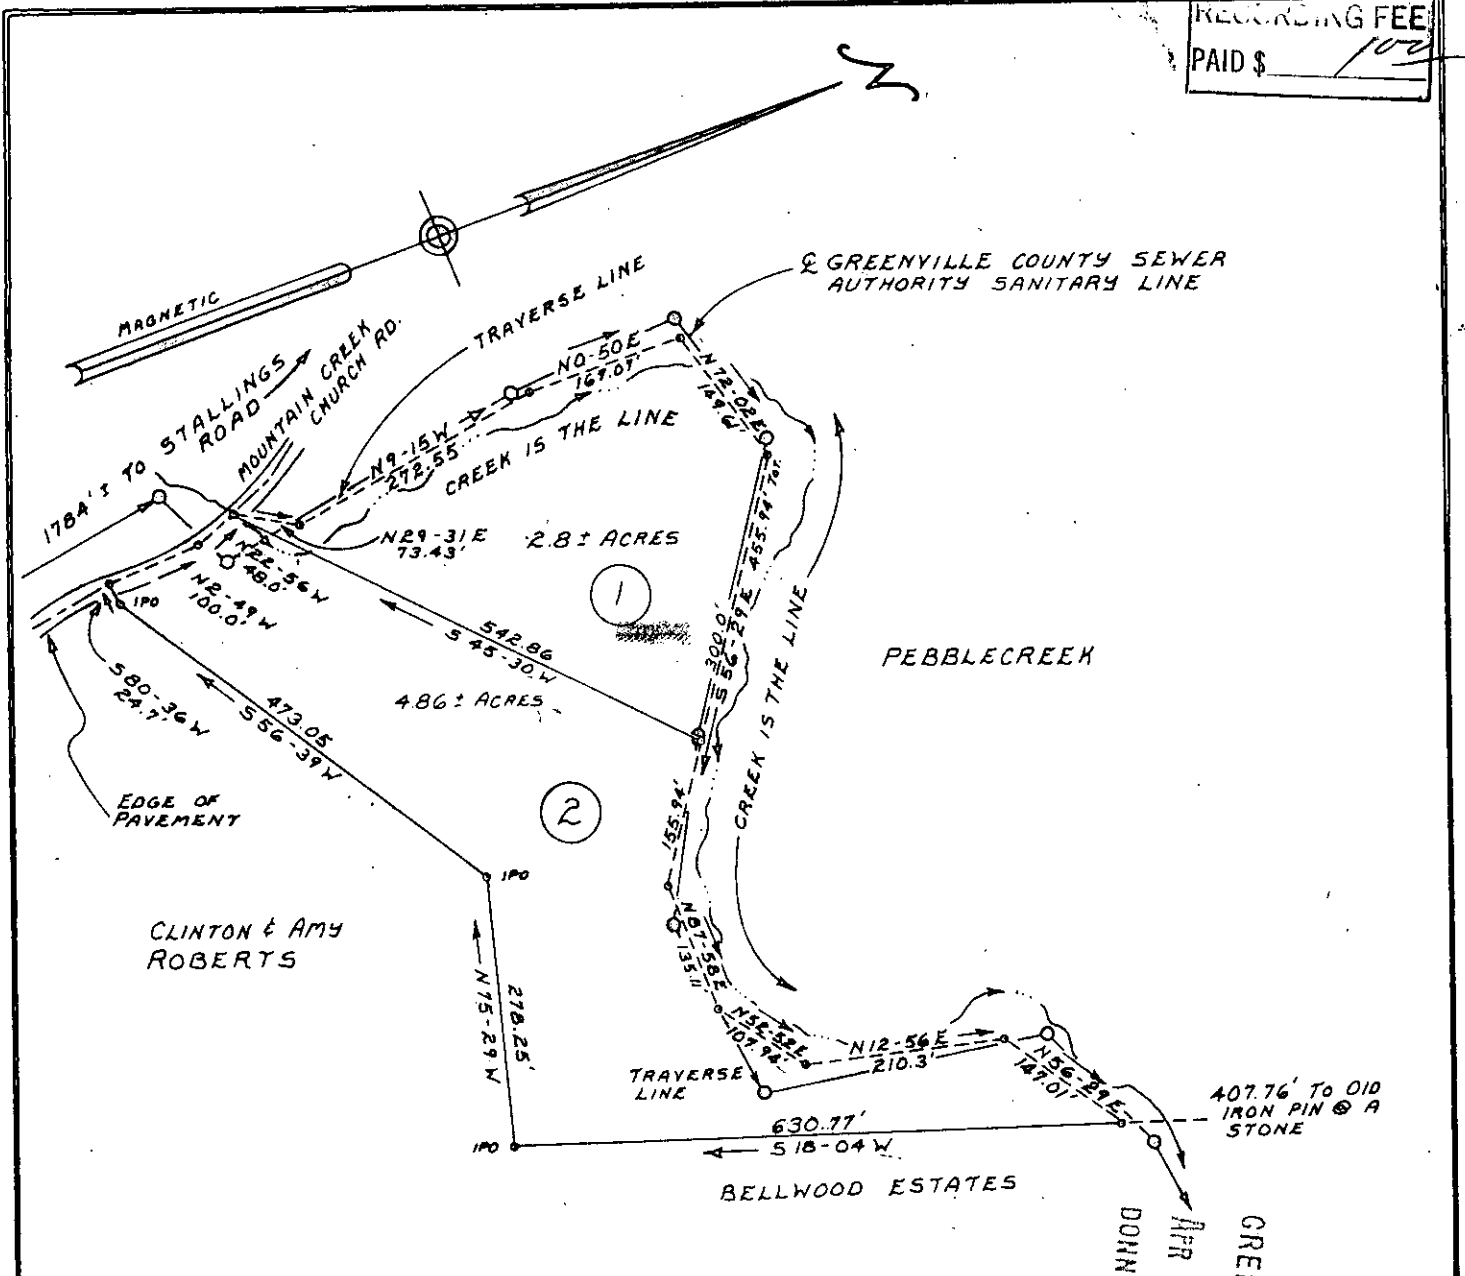

PROPERTY OF
SUE F. JONES
 PARIS MOUNTAIN TOWNSHIP
 GREENVILLE CO. SOUTH CAROLINA
 FEB. 23, 1973 SCALE: 1" = 200'

FILED
 GREENVILLE CO. S.C.
 APR 2 11 39 AM '73
 DONNIE S. TANKERSLEY
 R.M.C.

44-12 APR 21 1973

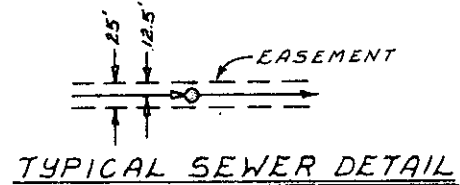

PLAT AMENDED 3-29-73
 TO SHOW SANITARY SEWER LINE
 AND MANHOLES.
27832


enwright associates
 ENGINEERS
 GREENVILLE, S. C.