


RECORDING FEE
PAID \$ 15.00

OLD SPARTANBURG ROAD
S-94 DKT. 23.642

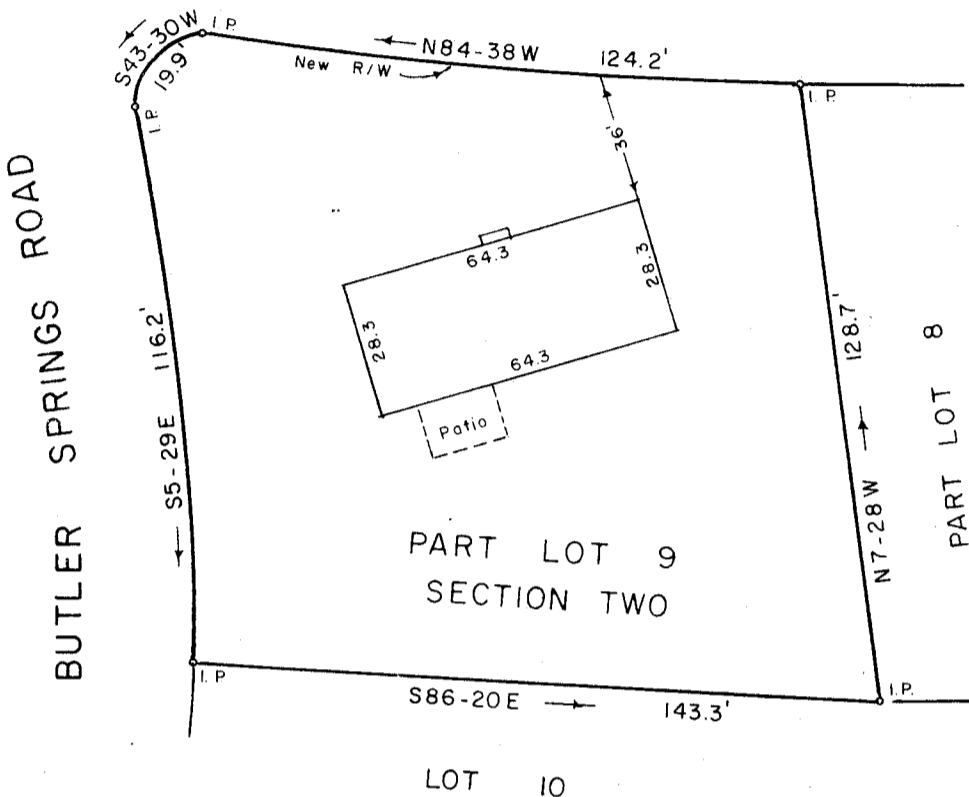

PROPERTY OF
 COLIN DOUGLAS HEATON
 JANICE B. HEATON
 GREENVILLE CO., S. C.

Scale 1" = 40' October, 1973

This is to certify that on the 23rd day of October, 1973, We surveyed the property shown on this plat; being known as part of Lot 9, Section Two on plat of Spring Forest, Recorded in Plat Book BBB page 34, Office of R. M. C. Greenville Co., S.C.; and that the property lines, walls and buildings are as shown hereon; that the buildings located on said lot do not encroach or project on adjacent streets or property; and that no adjacent buildings or walls encroach or project on said premises.

4Z-88

R. W. Heaton
 Dalton & Neves Co., Engineers.
 S.C. Number Register 916
 916

FILED
 GREENVILLE CO. S. C.
 OCT 24 4 01 PM '73
 DONNIE S. TANKERSLEY
 R.M.C.

F. 39

OCT 24 1973 11350
 OCT 24 1973 4Z-88