


RECORDING FEE PAID \$ 10.00 R.M.C.

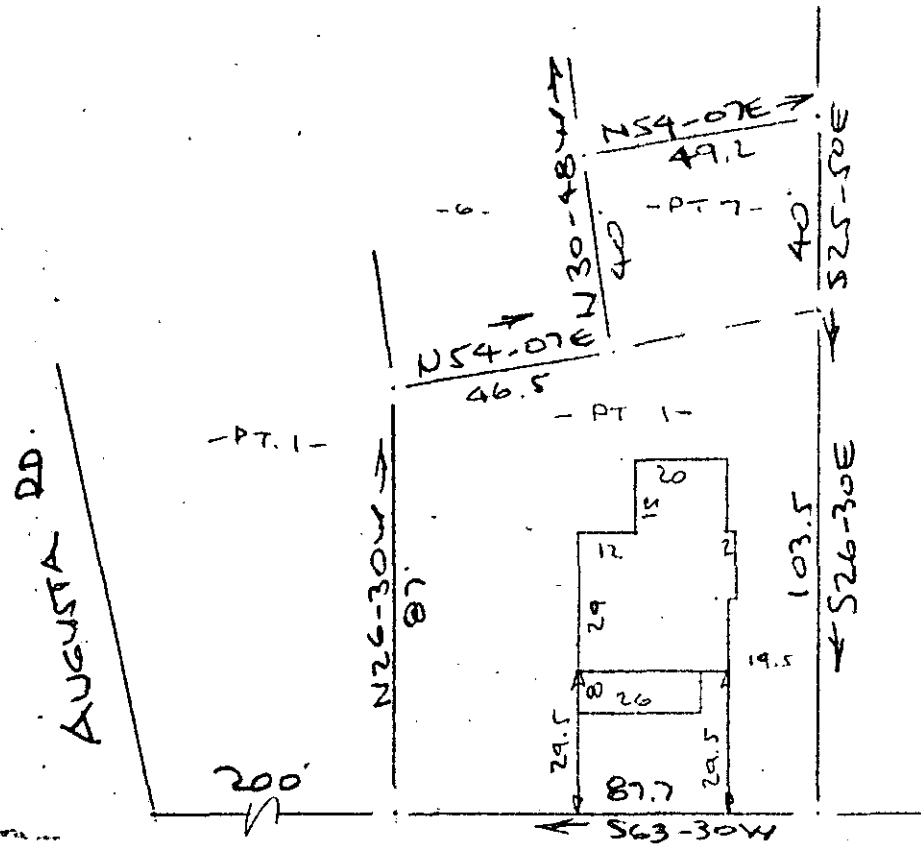

OREGON ST. WATER & SEWER IN ST. RUN

FILED GREENVILLE CO. S. C. AUG 3 12 56 PM '73 DONNIE S. TANKERSLEY R.M.C.

PROPERTY OF ALAN R. MILLER & PHYLLIS A. MILLER GREENVILLE, S. C. SCALE: 1" = 40' AUG 1973

This is to certify that on the 1st day of August 1973, I surveyed the property shown on this plat, being known as part of lot 1 -Block "C" & part of lot 7 on plat of KANATHENAH SUBDIVISION and recorded in the RMC Office Greenville County, S. C., in Plat Book "F" at Pages 131 & 132; and also known as PROPERTY OF ALAN R. MILLER & PHYLLIS A. MILLER and recorded in RMC Office in Plat Book at Page ; and that the property lines, walls and buildings are as shown hereon, and that the walls and buildings located on said lot do not encroach or project on adjacent street or property. and that no adjacent walls or buildings encroach or project on said premises and no power lines cross this property except as shown hereon.

AUG 3 1973

5C-8 ✓

CAROLINA SURVEYING COMPANY 112 Manly St. Greenville, S. C.

R. B. Bruce, RLS #1952 AUG 3 1973 3629

AUG 3 1973