



FILED
GREENVILLE CO. S.C.
AUG 15 1 38 PM '73
DONNIE S. TANKERSLEY
R.M.C.

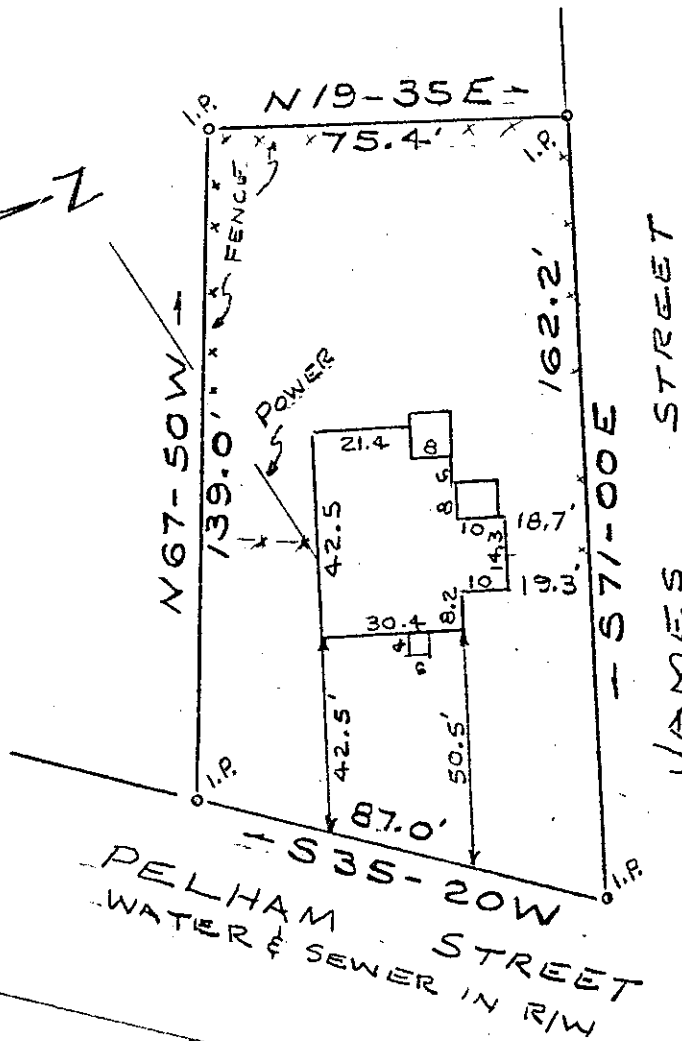

This is to certify that on August 3, 1973, I surveyed the property shown on this plat, known as Lot of John J. Hickey, Sr. and Rebecca M. Hickey filed in R.M.C. Office, Greenville County, S. C. in Plat Book 4A, Page 185, and that the property lines and buildings are as shown hereon; that the buildings located on said lot do not encroach or project on adjacent streets or property, and that no adjacent walls or buildings encroach on said premises, and that no utility lines cross this property EXCEPT as shown hereon.

Robert S. Jones
Robert S. Jones RLS 4783

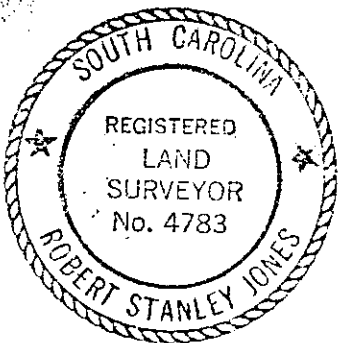

PROPERTY OF
BOYCE E. & NETTIE JANE OWENS
STATE OF SOUTH CAROLINA
GREENVILLE COUNTY
CITY OF GREER

AUG 15 1973

4869

5C-17

RECORDING FEE
PAID \$ 1.00

DR. J. H. S.
CHK. R. S. W.
SCALE 1" = 40'
DATE:
AUG 3, 1973
ADDRESS:
GREENVILLE
S.C.