

HENRY J. NIX

I.P. (OLD)

S 11°-55' E

I.P. (OLD)

MICROFILMED

FILED
GREENVILLE CO. S. C.

OCT 22 3 31 PM '73

DONNIE S. TANKERSLEY
R.M.C.

RECORDING FEE
PAID \$

MAG. NORTH

6

5

4

40' B.L.


N 78°-05' E
180.0'

SEPTIC TANK

180.0'
S 78°-05' W

POWER & PHONE
LINES

I.P. (OLD)

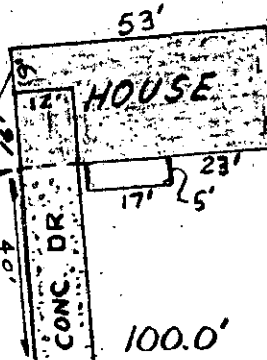

10' DRAINAGE EASEMENT

N 11°-55' W

APPROX. 390' TO
FARR'S BRIDGE ROAD.
WATER IN STREET R/W

HARBOR DRIVE


R/W

This is to certify that on October 16, 1973, I surveyed the property shown on this plat, known as Lot No. 5 on plat of Lake Harbor, filed in the R.M.C. Office for Greenville County in Plat. Book MM at page 15, and that the property lines, walls and buildings are as shown hereon; that the buildings located on said lot does not encroach or project on adjacent streets or property, and that no adjacent walls or buildings encroach or project on said premises, and that no utility lines cross this property except as shown hereon.

OCT 22 1973

5C-103
11102

Robert S. Jones R.L.S. 4782
Robert S. Jones R.L.S. 4782

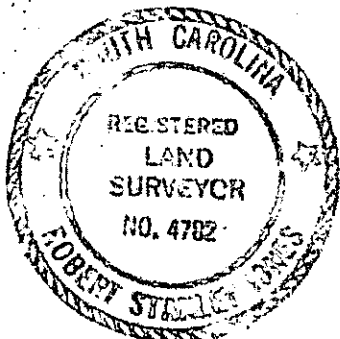

SEAL

STATE OF SOUTH CAROLINA
GREENVILLE COUNTY
LAKE HARBOR - LOT 5

PROPERTY OF
MARVIN J. LAMBERT &
DOROTHY W. LAMBERT

FREELAND-JONES
&
ASSOCIATES

Greenville, South Carolina

SURVEY: R.S.J.

DR: R.S.J.

CH: Robert S. Jones

SCALE: 1"=40'

DATE: OCT. 16, 1973

DWG. NO. 73-33