279.57 12 05 42

273.40 17 59 38

50.00 50 33 04

50.00 53 50 39

341.09 18 36 30

391.09 10 03 31

229.57 11 50 06

398.14 08 14 04

398 - 14 11 15 37

398.14 01 45 19

15.26

43.93

63.08 50.00 72 16 51 36.51 58.98 N45 28 358 56.55 50.00 64 48 17 31.73 53.59 N65 58 51E 42.64 277.35 8 48 32 21.36 42.59 N84 45 48E 82 24 277.35 16 59 22 41.42 81 94 N71 35 48E 86.62 273.40 18 09 11 43 68 86 26 \$47 53 25 E

43.29 36.99

75.61 \$64 11 39E

73.32 NB2 02 IOE

67.29 N87 54

61 . 19 N80 05 51

110.29 N78 10 49H 95.89 N60 47 44H

97.55 N44 29 36H 91.45 N28 34 04W


166.21 N33 07 58H 68.57 N50 25 52H 68.19 N60 27 41H

47.92 NB1 04 45E

MAGNE 1(

* REV. 9/26/7% REVISED LOTS 18-24

FORTIS ENTERPRISES

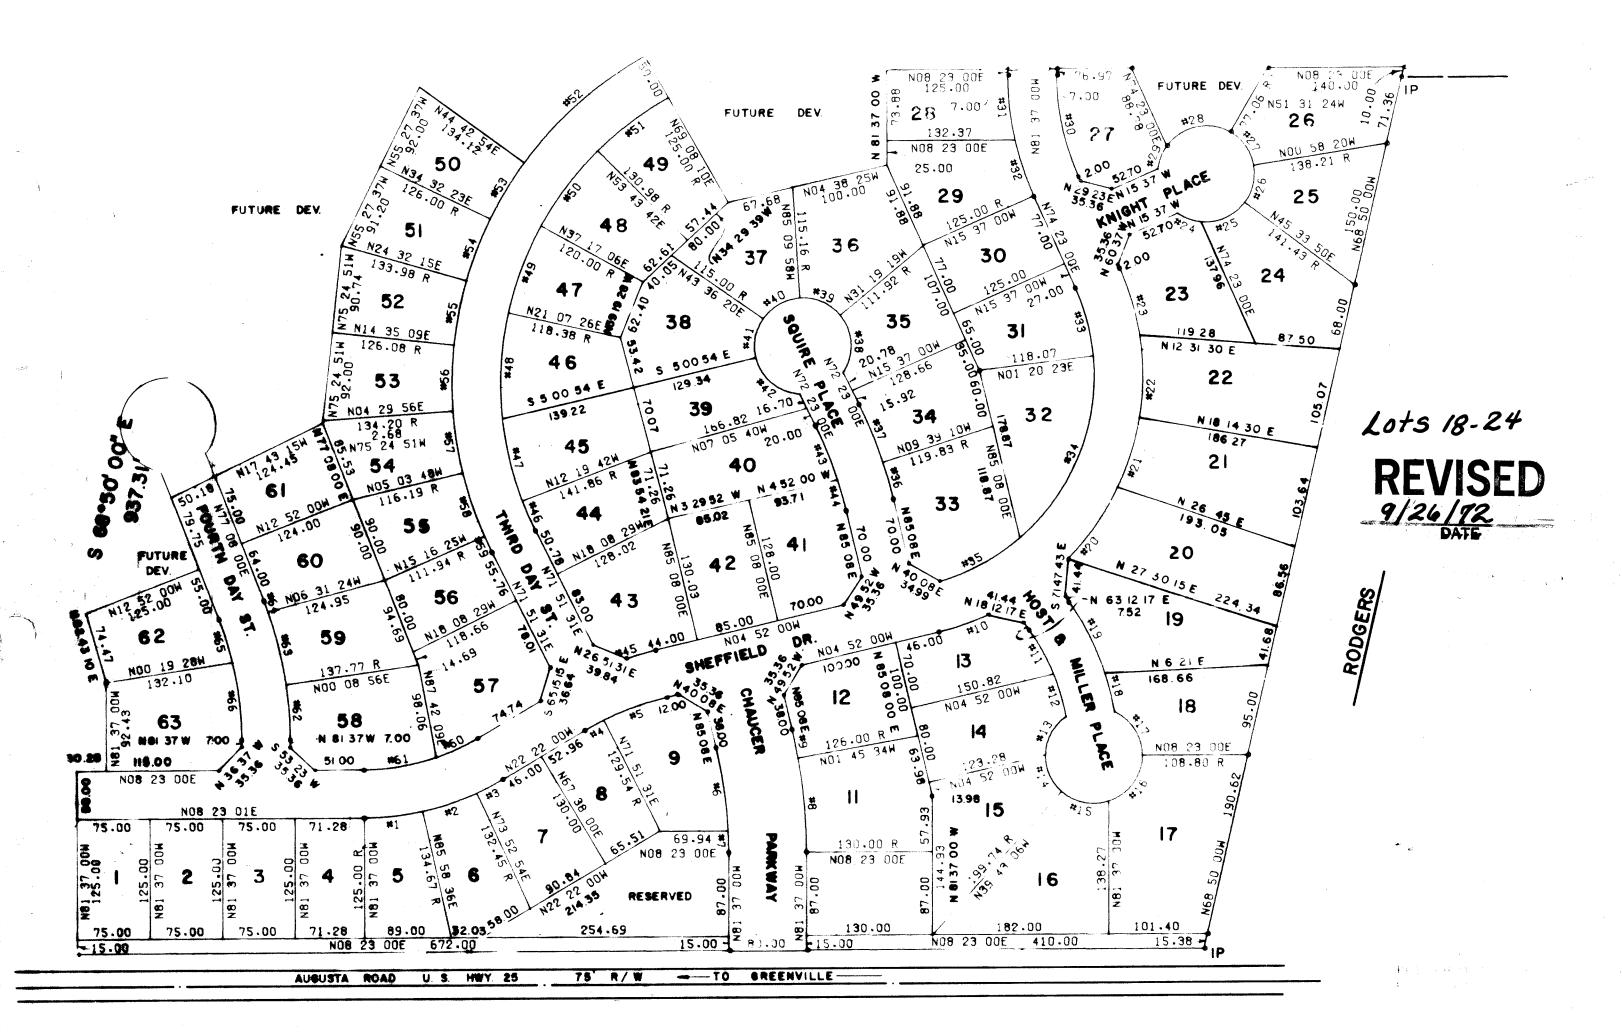

NOTE: There wil be a 5' drainage and utility easement along all side and rear lot lin**es.**

I centify that the above plat was to a code my supervision and that the minimum error of closure of the plat as 1:3000.

- 15755 5 D-pg. 16

39.25

6.10 348.14 07 53 31 24.01 47.92 N81 04 45E 348.14 13 21 29 40.77 80.98 N88 17 44H

FINAL PLAT

CERTIFICATE OF OWNERSHIP AND DEDICATION

"The undersigned hereby acknowledge that I am (we are) the owner(s) of the property shown and described hereon and that I (we) hereby adopt this plan of subdivision with my (our) free rsent and that I (we) establish the minimum building restriction lines, and hereby dedicate to

12173		a Placy
/ /	Signed	/
//	Signed	· · · · · · · · · · · · · · · · · · ·
/ /	Signed	

CERTIFICATE OF ACCURACY

me) (deed description recorded in Book Page _____, etc.) (other); that the error of closure as calculated by ides and departures is ______, that the boundaries not surveyed are shown as en lines plotted from information found in Book was prepared in accordance with the Greenville County Subdivision Regulations

ea.	
12/3/73	W. T. Beanes
DATE	LICENSED ENGINEER OF REGISTERED SURVEYOR
Registration No. 235	-9

85.51 SOLIS 24E CERTIFICATE OF APPROVAL FOR RECORDING

49.70 N14 37 561 hereby certify that the subdivision plat shown hereon has been found to comply with 39.50 N67 42 1666 Subdivision Regulations for Greenville County, with the exception of such variances, if 42.70 N63 45 066 as are noted in the minutes of the Greenville County Planning Commission of Greenville 67.48 N03 57 496 nty, South Carolina, and that it has been approved for recording in the office of the 106.98 N86 23 006

DEC.12 1913

DIRECTOR OF PLANNING
GREENVILLE COUNTY PLANNING COMMISSION

FILE NUMBER

72-105

CANTERBURY SUBD. SECTION I

68.76 N80 27 27H FORTIS ENTERPRISES GREENVILLE, S. C.

HEANER ENGR. CO. INC GREENWOOD, S. C.

NO. OF ACRES 22.69

MILES OF NEW ROAD 0.81

NO. OF LOTS 63

DATE: 3/22/72 REVISION: 4/7/72 9/26/72

AZTSURVET SZINNOG SCALE: 1"= 100'