


MICROFILMED

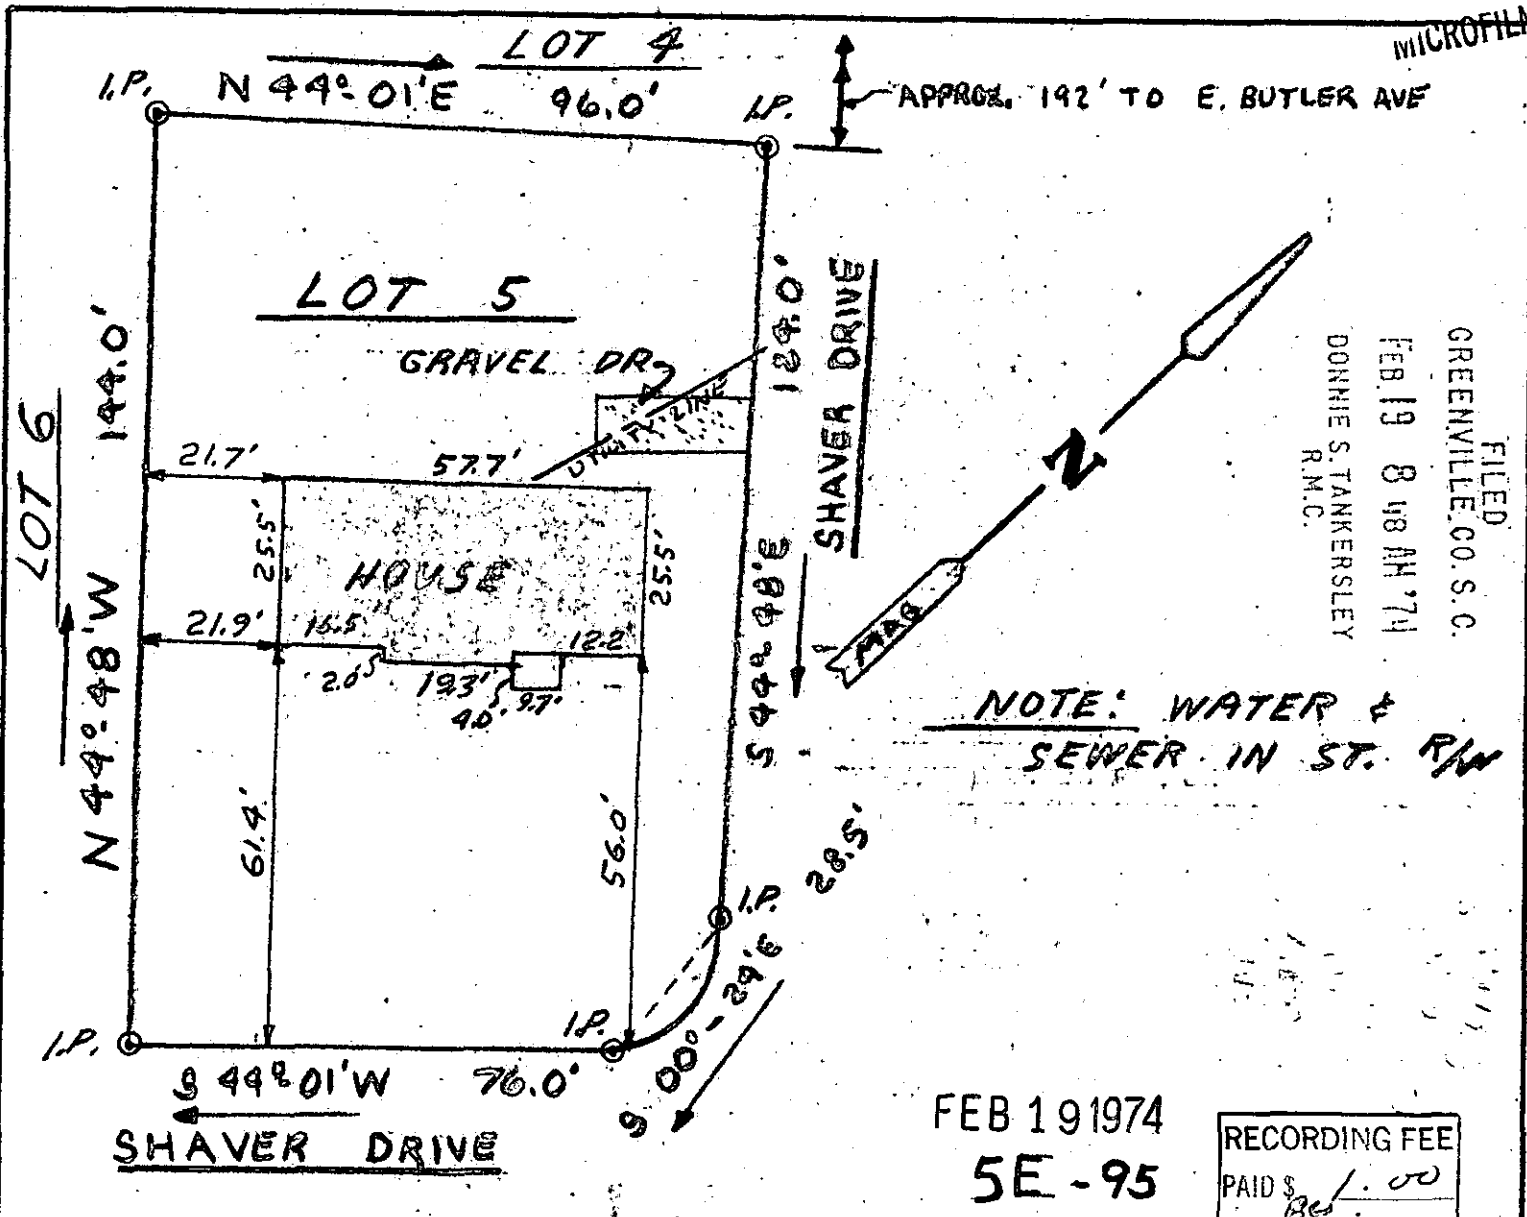

FILED  
GREENVILLE CO. S.C.  
FEB 19 8 48 AM '74  
DONNIE S. TANKERSLEY  
R.M.C.

FEB 19 1974  
5E-95


RECORDING FEE  

This is to certify that on February 14, 1974, I surveyed the property shown on this plat, known as Lot 5 on plat of property of J.O. Shaver filed in R.M.C. Office for Greenville County in Plat Book LL at Page 20, and that the property lines and buildings are as shown hereon; that the buildings located on said lot do not encroach or project on adjacent streets or property, and that no adjacent walls or buildings encroach on said premises, and that no utility lines cross this property except as shown.

*James R. Freeland*  
James R. Freeland R.L.S. 4781

Blk. Bk. M 4.1-1-17

20467

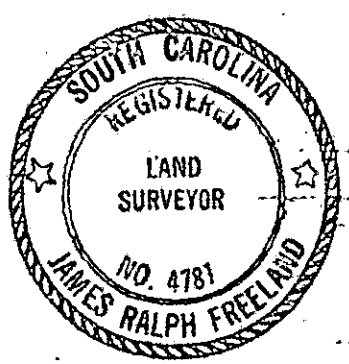

**STATE OF SOUTH CAROLINA  
GREENVILLE COUNTY**

**J.O. SHAVEN PROP.**

**LOT # 5**

**PROPERTY OF**

**LARRY DWIGHT FISHER &  
FRY L. FISHER**

**FREELAND-JONES & ASSOCIATES**  
GREENVILLE, S.C.

SURVEY T.S. & P.L.  
DRAWN F.L. & J.R.F.  
CHECK J.R.P.  
SCALE 1" = 30'  
DATE FEB-14, 1974  
DWG. NO. 74-28-CN

SEAL