


MICROFILMED

WEST BUTLER AVE.

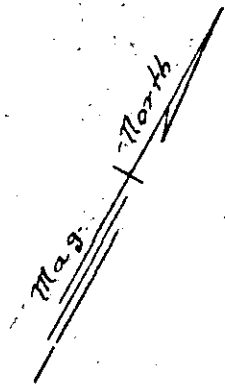


40' DRIVE

FUTURE 25' ROAD

U.S. HWY. NO. 276

EXIST. HARDWARE STORE

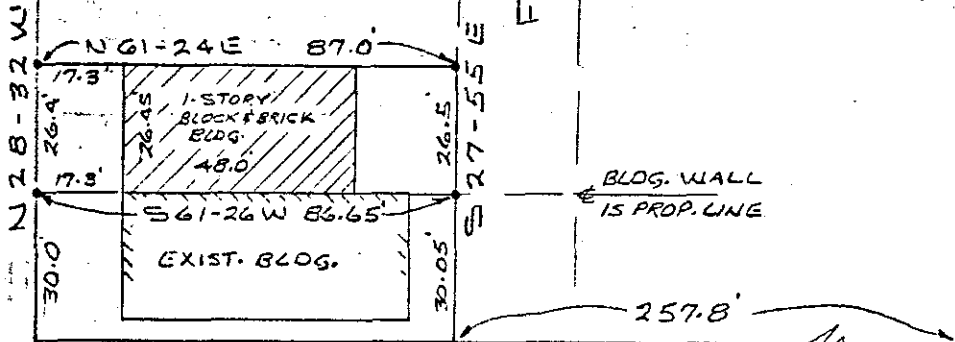

- DRIVE -

FEB 22 10 53 AM '74
DONNIE S. TANKERSLEY
R.M.C.

5E-100

SURVEY FOR
FLOOGLE, INC.
MAULDIN, S.C.
SCALE 1"=40' FEB. 13, 1974

20867

RECORDING FEE
PAID \$ 1.00

PIEDMONT ENGINEERS - ARCHITECTS - PLANNERS
GREENVILLE, S. C.



FILED
GREENVILLE CO. S.C.