


N 31-23 E

RD. R/W

PINE CREEK COURT EXT.


PARKING AREA

BLDG. No. 18
TYPE C


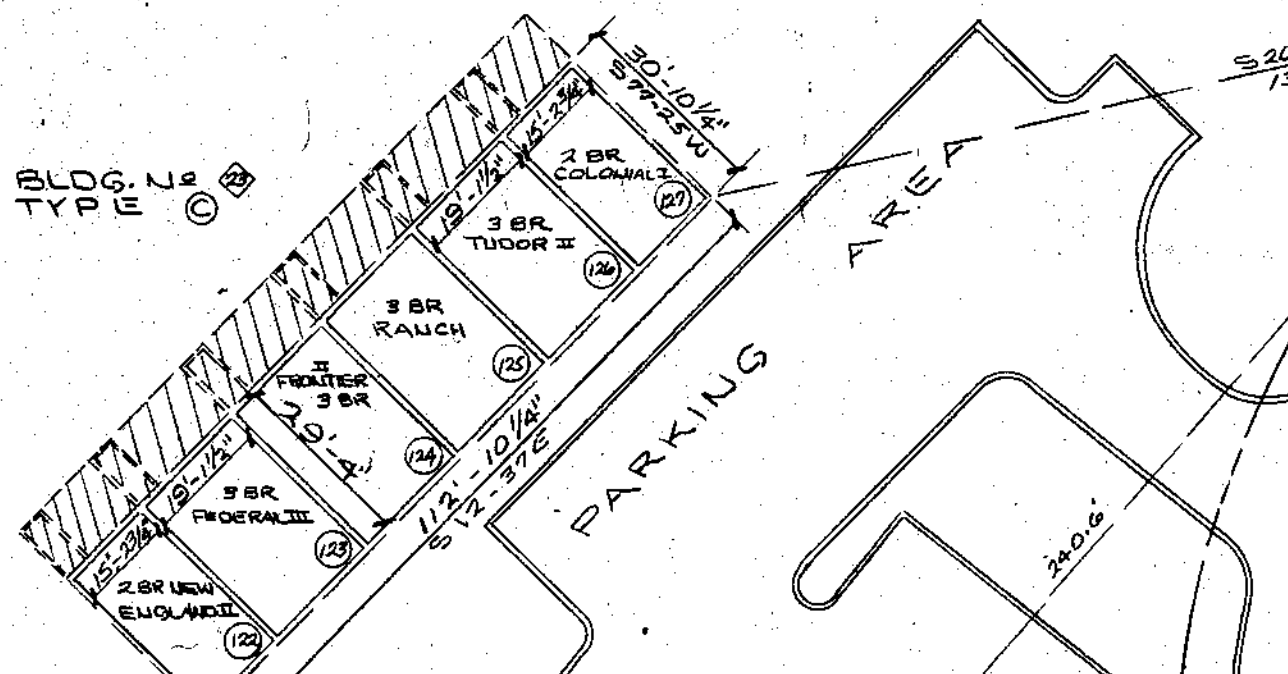


PARKING AREA

BLDG. # 19
TYPE 'F'

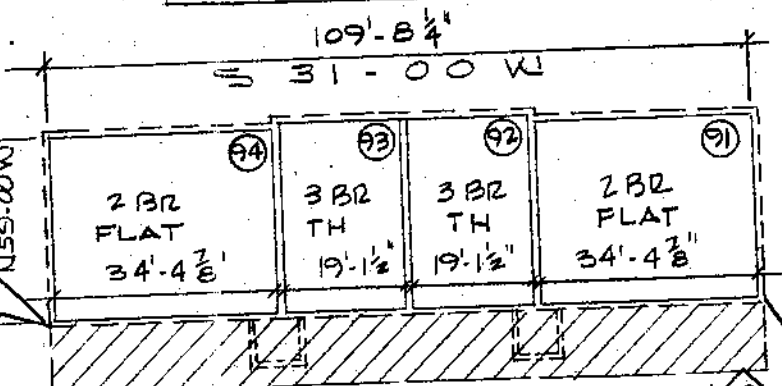

BLDG. # 18
TYPE 'F'

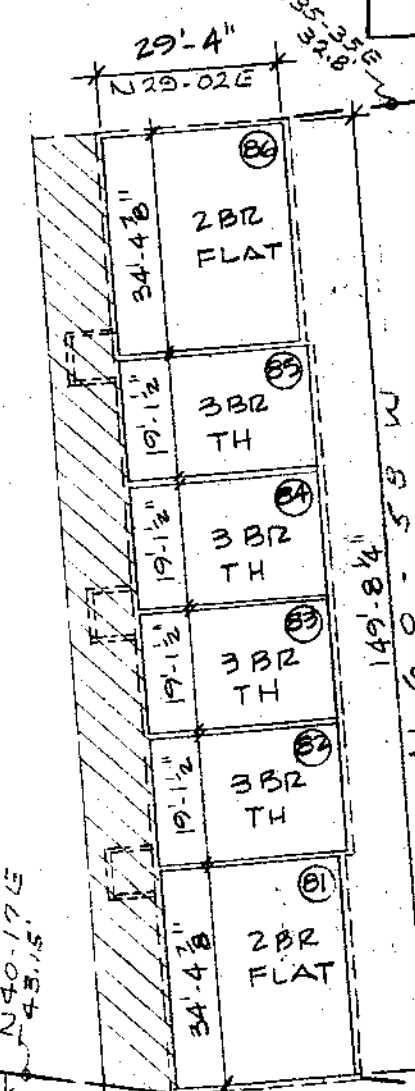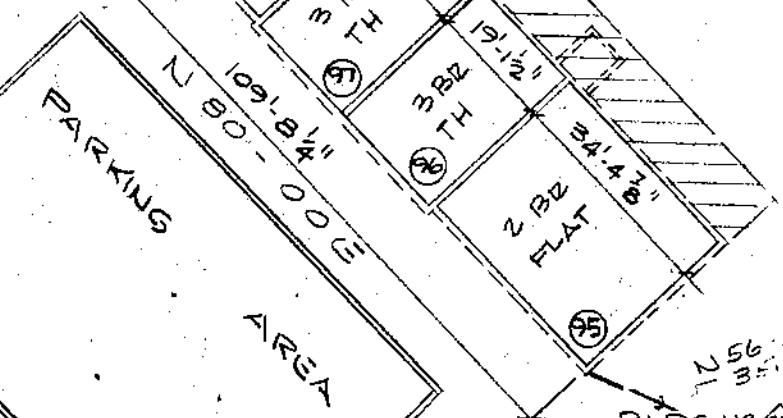

BLDG. # 16
TYPE 'H'


Magnetic North

LEGEND
 ——— BOUNDARY OF UNIT
 - - - - - COMMON ELEMENTS
 ▨ LIMITED COMMON ELEMENTS

**THE HIGHLANDS
 HORIZONTAL PROPERTY REGIME
 NEAR GREENVILLE, S.C.**

PLOT PLAN SCALE 1"=30'
 REV. 7-27-73
 REV. 12-27-73

SHEET 3 OF 3

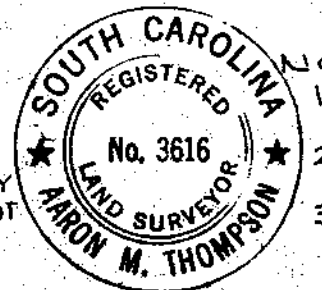

I, AARON M. THOMPSON, HEREBY CERTIFY THAT THE WITHIN PLOT PLAN SHOWS THE LAYOUT OF THE BUILDINGS & OTHER IMPROVEMENTS & IS TRUE AND CORRECT TO THE BEST OF MY KNOWLEDGE.

DATED THE 1ST DAY OF AUGUST, 1972
 REG. LAND SURVEYOR NO. 3616

FOR DEDICATION OF ROADS SEE
 DEDICATION BOOK / PAGE 172

- NOTES:**
1. THE BUILDINGS SHOWN ON THIS PLAN CONSIST OF TWO & THREE BEDROOM UNITS.
 2. EACH UNIT CONSISTS OF THE SPACE BOUNDED BY THE UNDERCOATED AND/OR UNFINISHED SURFACES OF THE PERIMETER WALLS, FLOORS, AND CEILINGS.
 3. PARKING SPACES ARE LIMITED COMMON ELEMENTS NOT WITHSTANDING THE LEGEND AND SAID SPACES ARE FOR THE USE OF UNIT OWNERS. SPECIFIC PARKING SPACES TO BE ASSIGNED BY THE ASSOCIATION.
 4. SWIMMING POOL & RECREATION BLDG. ARE COMMON ELEMENTS NOT WITHSTANDING LEGEND.
 5. ALL INTERIOR ANGLES ARE 90°.

THIS PLAT IS NOT A SUBDIVISION AS DEFINED BY THE GREENVILLE COUNTY SUBDIVISION REGULATIONS.

2/28/74 *J. Roman House*
 Chairman, Secretary or Director of Planning
 Greenville County Planning Commission

21478

PIEDMONT ENGINEERS & ARCHITECTS
 GREENVILLE, S.C.

FILED
 GREENVILLE CO. S.C.
 FEB 28 3 57 PM '74
 DONNE S. TANNER-ESLER
 R.M.C.

FEB 28 1974

RECORDING FEE
 PAID \$ 3.00

MATCH