


MICROFILMED

RECORDING FEE
X
FADG
150

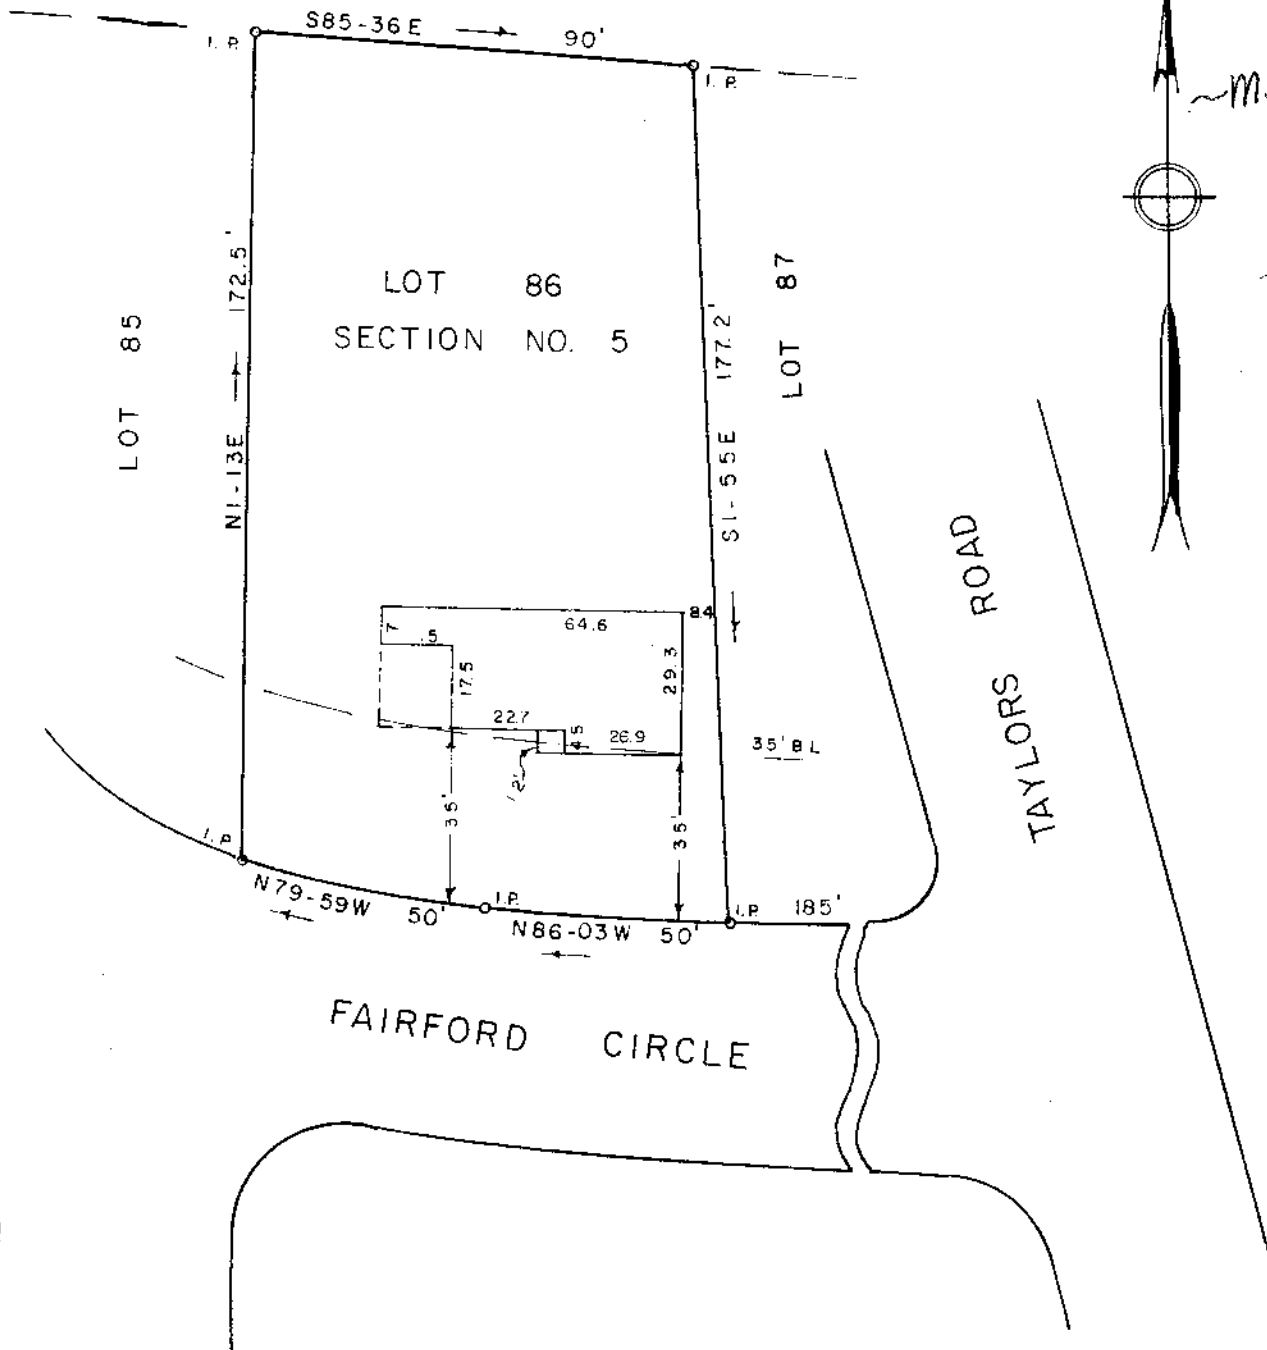

PROPERTY OF
 DANIEL N. BALMAN
 SALLY BALMAN
 GREENVILLE CO., S. C.

Scale 1" = 40' March, 1974

FILED
 GREENVILLE CO., S. C.
 MAR 14 2 18 PM '74
 DONNIE S. TARKER/CLERK

This is to certify that on the 8th day of March, 1974, We surveyed the property shown on this plat; being known as Lot 86, Section No. 5 on plat of Colonial Hills, Recorded in Plat Book 440 page 21, Office of R. F. C. Greenville Co., S. C.; and that the property lines, walls and buildings are as shown hereon; that the buildings located on said lot do not encroach or project on adjacent streets or property; and that no adjacent buildings or walls encroach or project on said premises.

MAR 14 1974

22787

R. W. Dalton

Dalton & Neves Co., Engineers



5F-23