

PROPERTY OF:
FRANK L. OUTLAW, JR., ET'AL
 MAULDIN, S.C.
 SCALE 1"=50'
 24 JULY 1974

✓5F-84



PROPERTY OF:
FRANK L. OUTLAW, JR., ET'AL
 MAULDIN, S.C.
 SCALE 1"=50'
 24 JULY 1974

✓5F-85

- LEGEND**
- ⊗ PP POWER POLE
 - ⊗ LP LIGHT POLE
 - ⊗ T&P TELEPHONE & POWER
 - PB POWER BOX
 - GM GAS METER
 - FH FIRE HYDRANT
 - MH MANHOLE
 - ▲ WM WATER METER
 - CB CATCH BASIN
 - ▲ WV WATER VALVE

- LEGEND**
- ⊗ PP POWER POLE
 - ⊗ LP LIGHT POLE
 - ⊗ T&P TELEPHONE & POWER
 - PB POWER BOX
 - GM GAS METER
 - FH FIRE HYDRANT
 - MH MANHOLE
 - ▲ WM WATER METER
 - CB CATCH BASIN
 - ▲ WV WATER VALVE

This is to certify that on the 24th day of July, 1974, I surveyed the property shown on this plan and that the buildings and other structures shown hereon are in their proper location and that the same are not in violation of any ordinance or law of the State of South Carolina. 

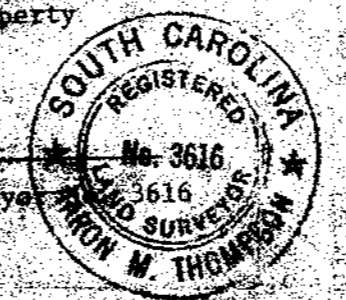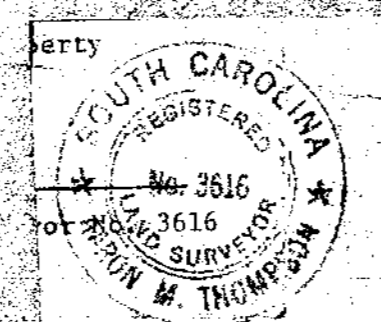


OCT 15 1974
 #9811

FILED
 GREENVILLE CO. S.C.
 OCT 15 1974
 DONNE S. TARKENTLEY

PIEDMONT ENGINEERS ARCHITECTS & PLANNERS

PIEDMONT ENGINEERS ARCHITECTS & PLANNERS

9811

FILED
 GREENVILLE CO. S.C.
 OCT 15 1974
 DONNE S. TARKENTLEY

35 1/2 x 24