
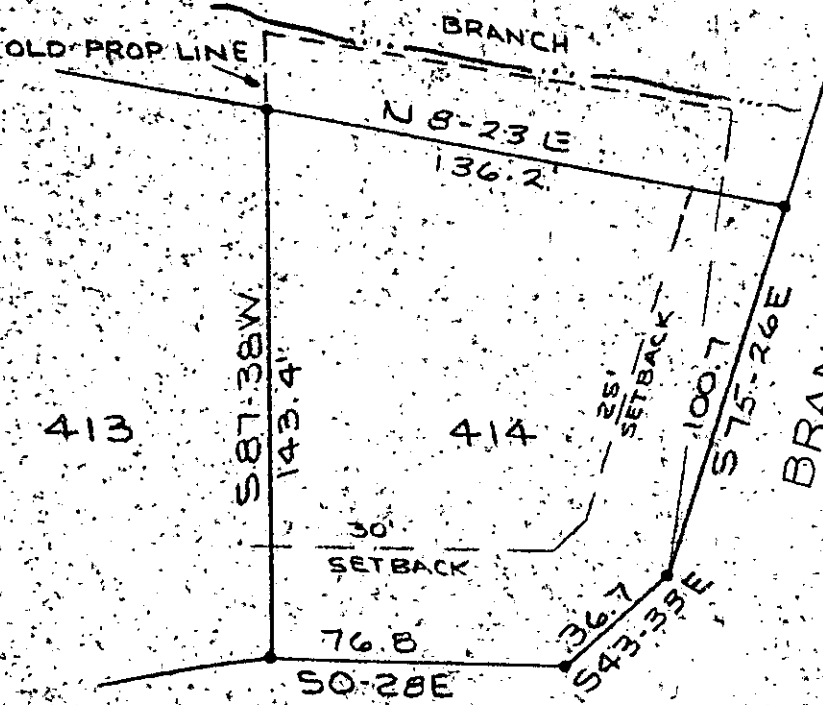


MICROFILMED

FILED
GREENVILLE CO. S.C.

MAY 17 2 46 PM '73
DORRIS S. TANKERSLEY
R.M.C.

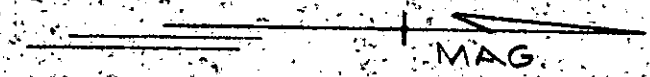

413

414

415


BRANSFIELD ROAD

BRANSFIELD ROAD

BRANSFIELD COURT

461

420

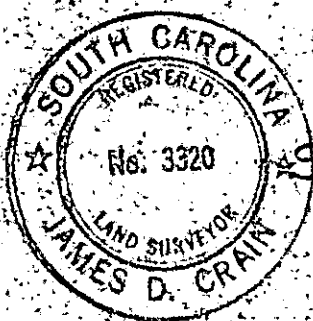

REVISION TO LOT 414
SECTION 5 - DEL NORTE ESTATES 29210

GREENVILLE CO., S.C.
SCALE 1"=50' JUNE 4, 1973

PIEDMONT ENGINEERS - ARCHITECTS - PLANNERS
GREENVILLE, S.C.

RECORDING FEE
PAID \$ 1.00

5G-53 ✓