


NOTTINGHAM ROAD

WATER & SEWER IN ST. RW.

MICROFILMED

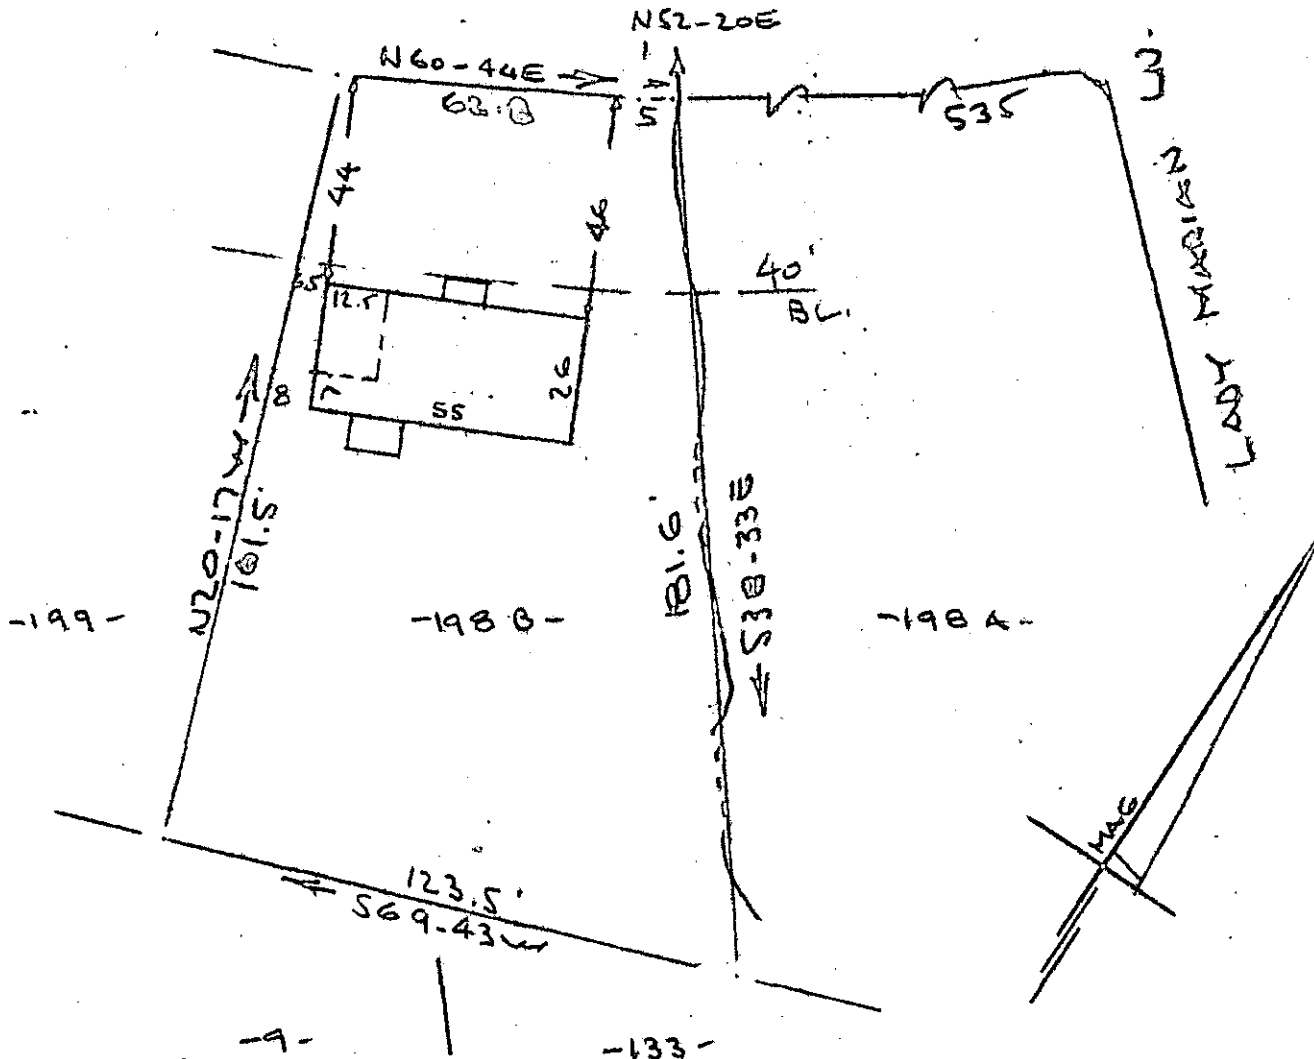

PROPERTY OF
PAUL C. AKERS
 GREENVILLE, S. C.
 SCALE: 1" = 40' 29 JUNE 1974

This is to certify that on the 29th day of June 1974, I surveyed the property shown on this plat, being known as lot 198B on a plat of SHERWOOD FOREST and recorded in the RMC Office Greenville County, S.C., in Plat Book "60" at page 70&71; and that the property lines, walls and buildings are as shown hereon, and that the walls and buildings located on said lot do not encroach or project on adjacent street or property, and that no adjacent walls or buildings encroach or project on said premises, and no power lines cross this property except as shown hereon.

FILED
 GREENVILLE CO. S. C.
 JUL 3 2 09 PM '74
 DONNIE S. TANKERSLEY
 R.M.C.

R. B. Bruce
 REGISTERED
 1952
 LAND SURVEYOR
 BRUCE

CAROLINA SURVEYING CO.
 112 Manly St.
 Greenville, S. C.

JUL 3 1974

RECORDING FEE
 PAID \$ 1.00

373
 5G-100