


FILED  
 GREENVILLE CO. S.C.  
 AUG 6 10 19 AM '74  
 DONNIE S. TANKERSLEY  
 R.M.C.

MICROFILMED

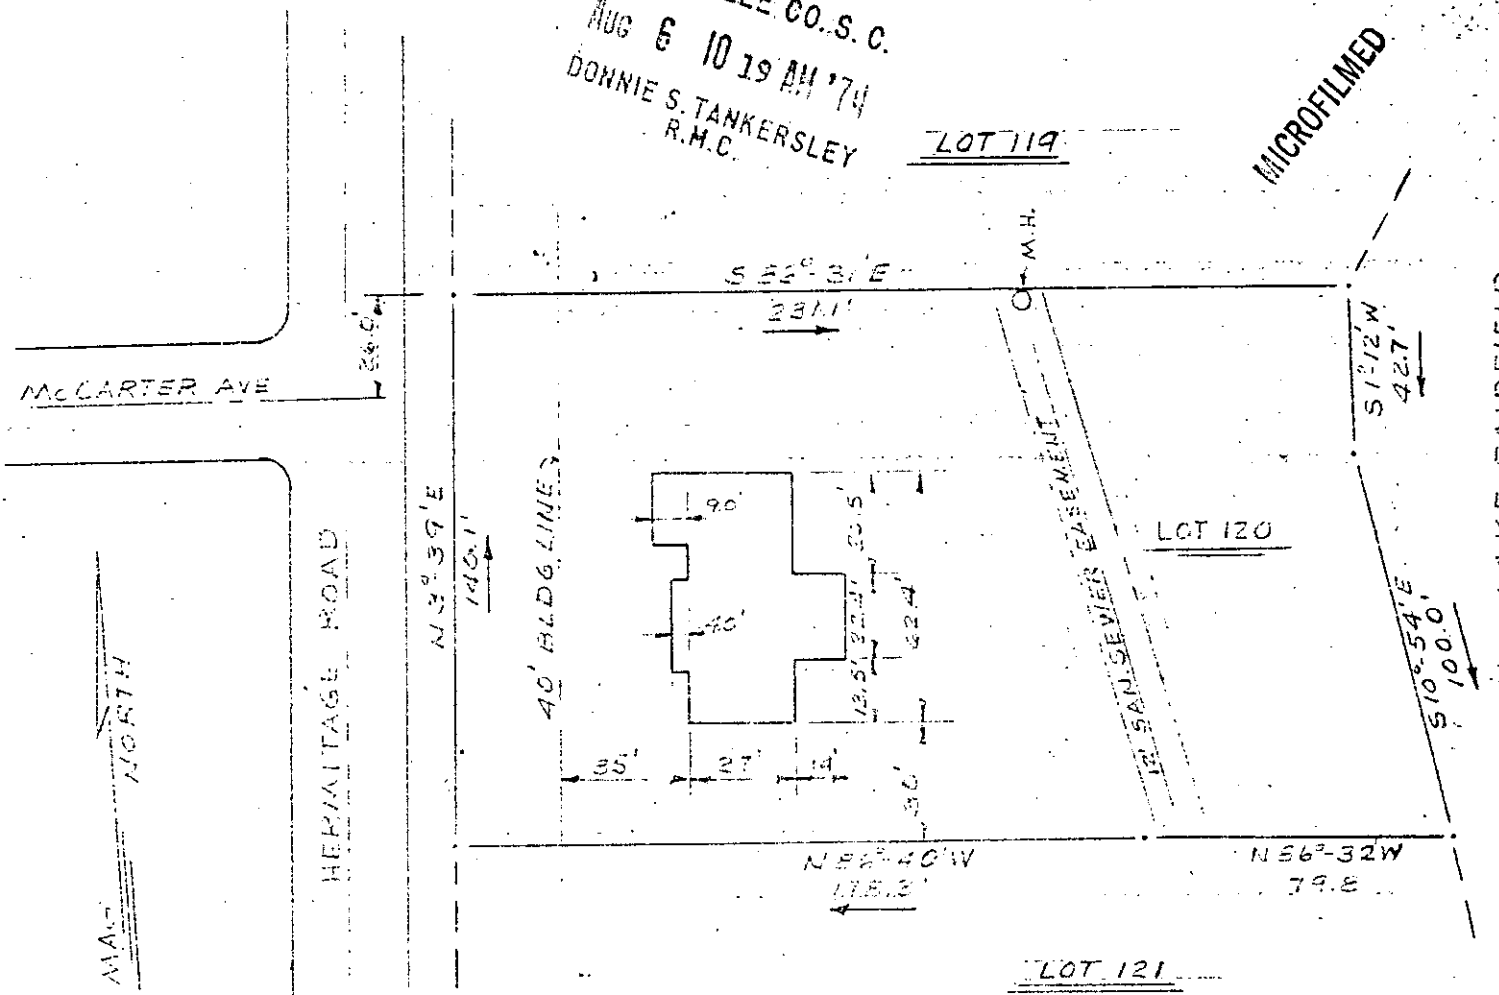


This is to certify that on August 5, 1974, I surveyed the said property shown on this plat, known as Lot #120 on plat of Lake Forest, filed in the R.M.C. Office for Greenville Co. in Plat Book BB at page 20, and that the property lines, walls and building are as shown hereon; that the building located on said lot does not encroach or project on adjacent streets or property, and that no adjacent walls or buildings encroach or project on said premises, and that no utility lines cross this property except as shown hereon.

Surveyed by James A. Freland RLS 4781

11 BARBARA AVE.  
 GREENVILLE, S.C.

STATE OF SOUTH CAROLINA  
 GREENVILLE Co.  
 LAKE FOREST S/D  
 LOT 120

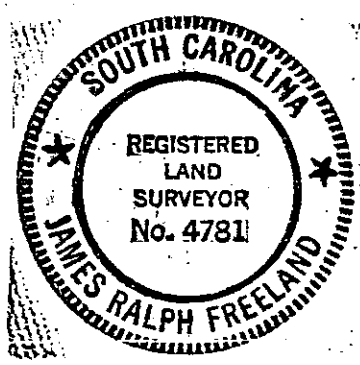

✓ 5G-140

RECORDING FEE  
 PAID \$ 1.00

AUG 6 1974

PROPERTY OF  
 WILLIAM B. HINES, JR. &  
 LINDA P. HINES  
 GREENVILLE - S.C.  
 SCALE 1"=50' AUG 5, 1974  
 IRONS ALL CORNERS

3666