


587-16
RECORDING FEE
PAID \$ 2.00

MICROFILMED

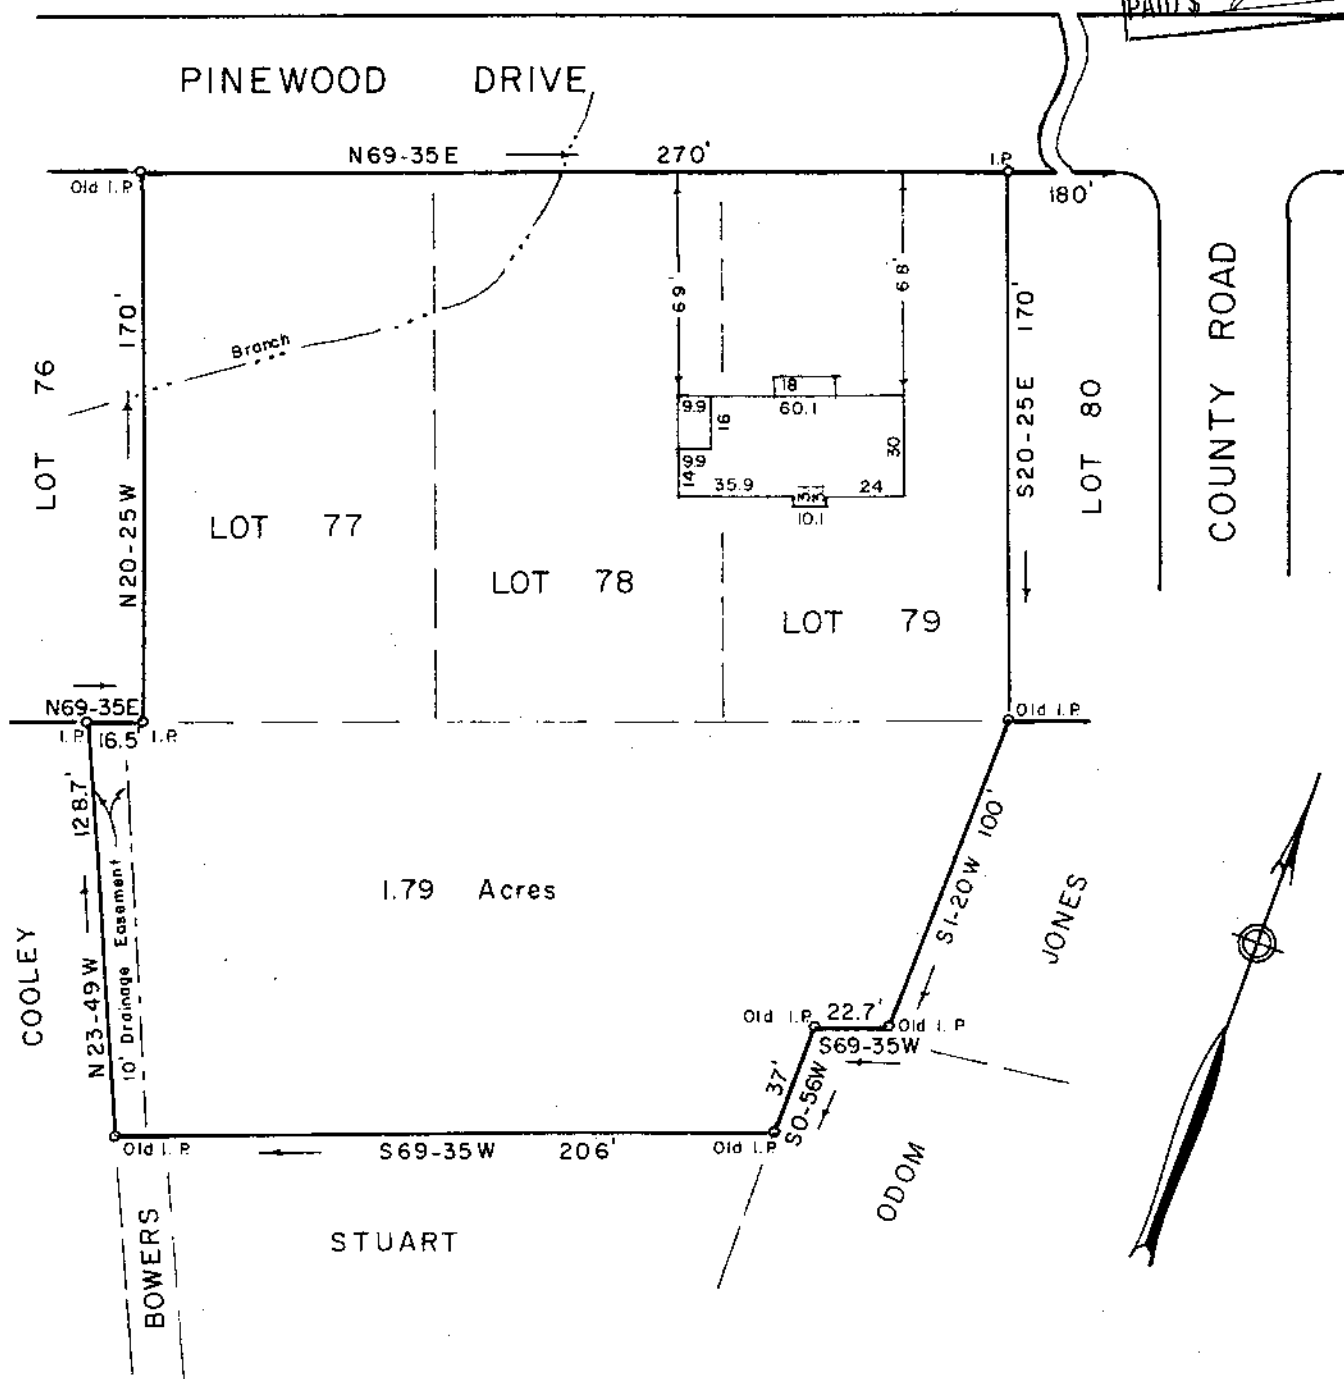


July 31 9:52 AM '74

PROPERTY OF
 PHILIP A. GIORDANO
 EDITH J. GIORDANO

GREENVILLE CO., S. C.

Scale 1" = 60' July, 1974

This is to certify that on the 26th day of July, 1974, We surveyed the property shown on this plat; being known as Lots 77-78-79 on plat of Pinewood Estate, Recorded in Plat Book MM Page 55 Office of R. M. C. Greenville Co., S. C.; and an adjoining parcel to the rear of said lots; and that the property lines, walls and buildings are as shown hereon; that the buildings located on said lots do not encroach or project on adjacent streets or property; and that no adjacent buildings or walls encroach or project on said premises.

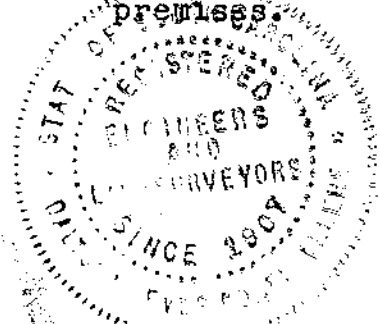

R. W. Dalton

 Dalton & Neves Co., Engineers

JUL 31 1974 54-16