


TRINITY LUTHERAN CHURCH

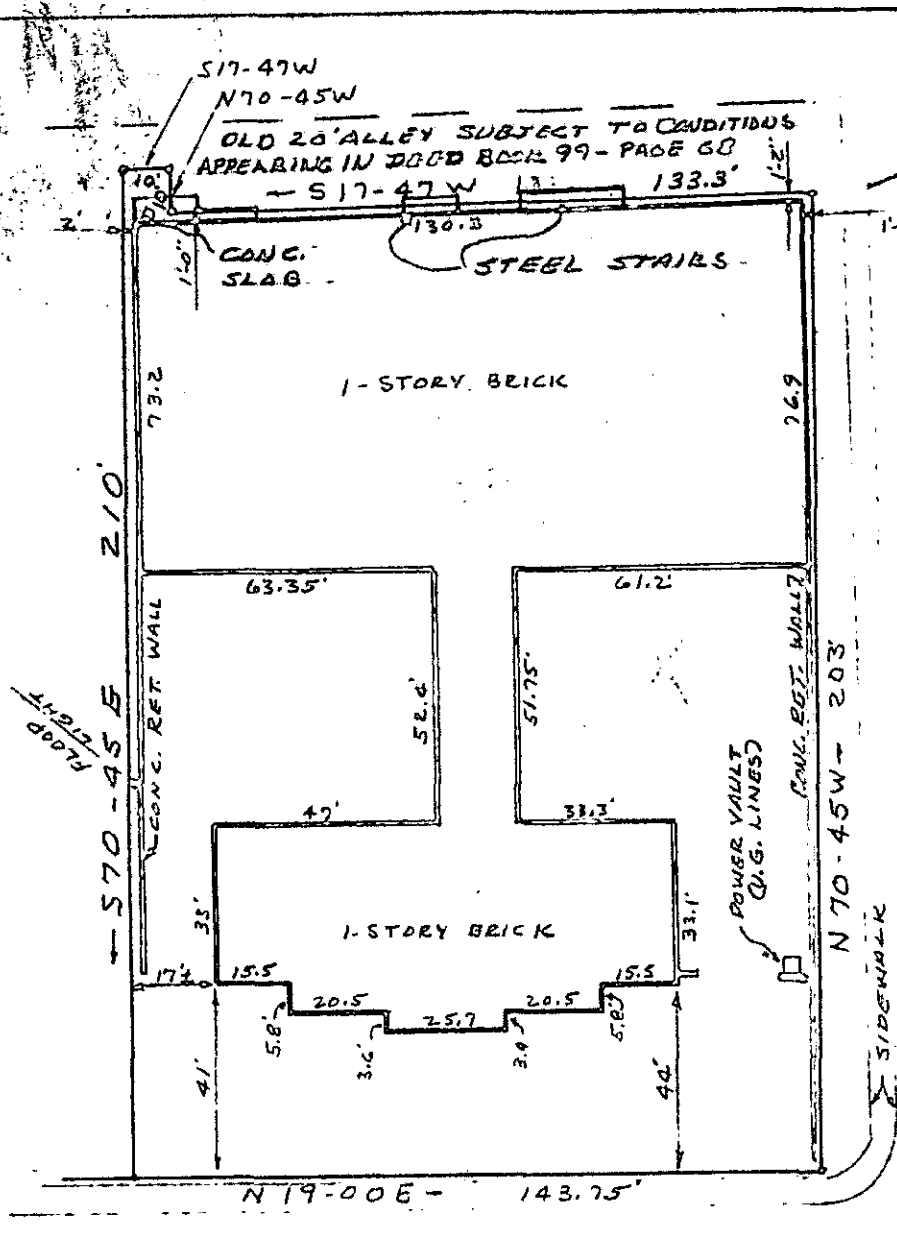

MAGNETIC
MICROFILMED

ACADEMY ST.

FILED
GREENVILLE CO. S.C.
NOV 4 10 35 AM '74
DONNIE S. TANKERSLEY
R.I.C.

NORTH MAIN ST.

PROPERTY OF
T. L. AYERS, JR. & J. B. STEPHENS
GREENVILLE, S.C.
OCT. 25, 1974 SCALE 1"=40'

This is to certify that on Oct. 25, 1974 I surveyed the property shown on this plat, shown in City Block Book for Greenville, S.C. on Page 3, Block 2, Lot 24, and that the property lines, walls and building are as shown hereon, and that the building located on said lot does not project nor encroach on adjacent streets or property except as may be shown hereon, and that no adjacent walls or buildings project nor encroach on said lot, and that no utility lines cross this lot except as may be shown hereon.

Survey by Campbell & Jackson
Surveyors, Inc.
C. CLARK, S. 2589

NOV 4 1974
51-101

RECORDING FEE
PAID \$ 1.00

11477