


MICROFILMED

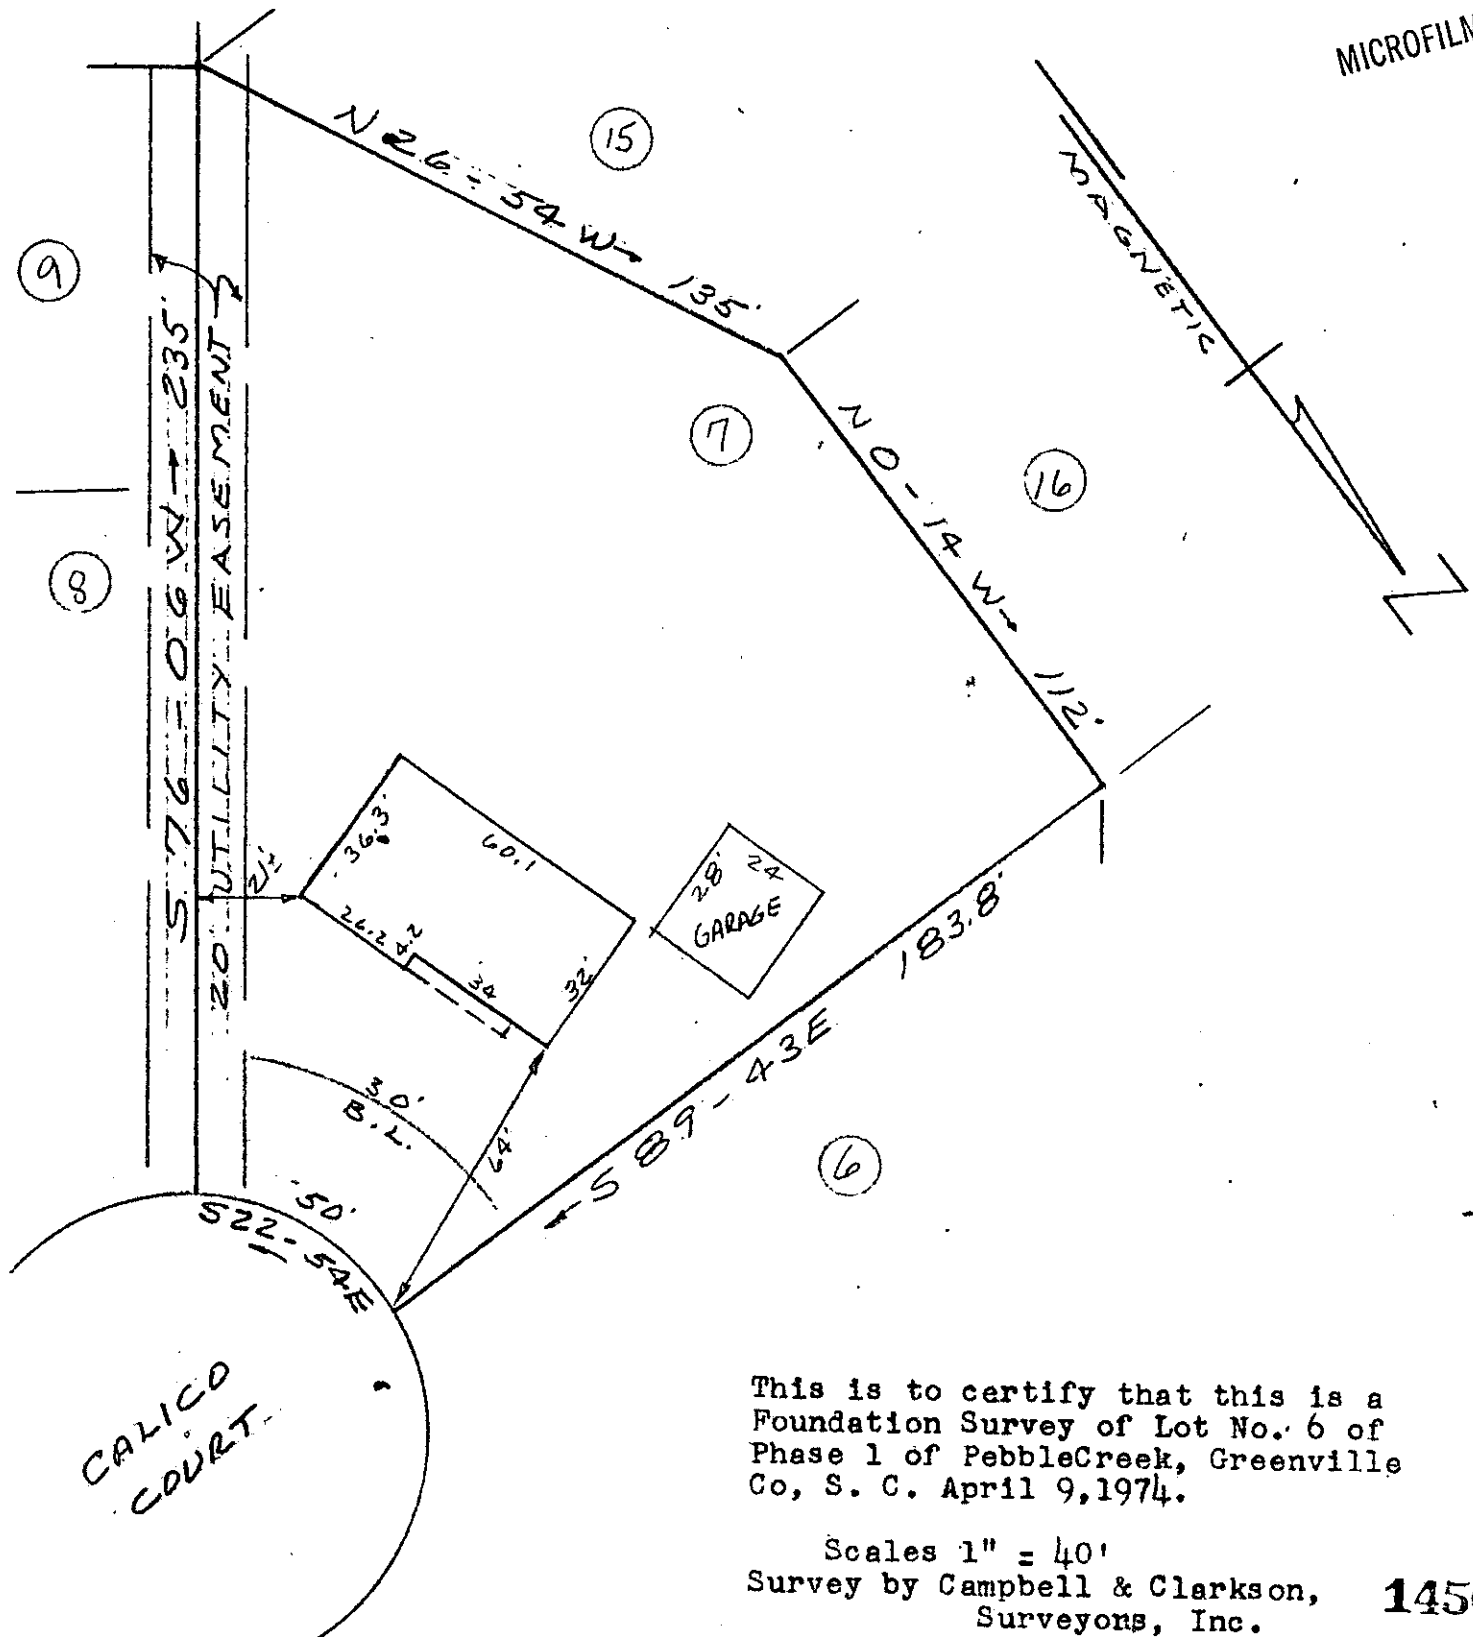

This is to certify that this is a
 Foundation Survey of Lot No. 6 of
 Phase 1 of PebbleCreek, Greenville
 Co, S. C. April 9, 1974.

Scales 1" = 40'
 Survey by Campbell & Clarkson,
 Surveyors, Inc. **14564**

DEC 13 1974

✓ 51-I-145

FILED
 GREENVILLE CO. S.C.
 DEC 13 2 39 PM '74
 DONNIE S. TANKERSLEY
 R.M.C.

H.C. Clarkson
 S.C.R.L.S. No. 2889
 SOUTH CAROLINA
 REGISTERED SURVEYOR
 CAMPBELL & CLARKSON

RECORDING FEE
 PAID \$ 1.00