


FILED  
GREENVILLE CO. S.C.  
JAN 9 4 30 PM '75  
DONNIE S. TANKERSLEY  
R.M.C.

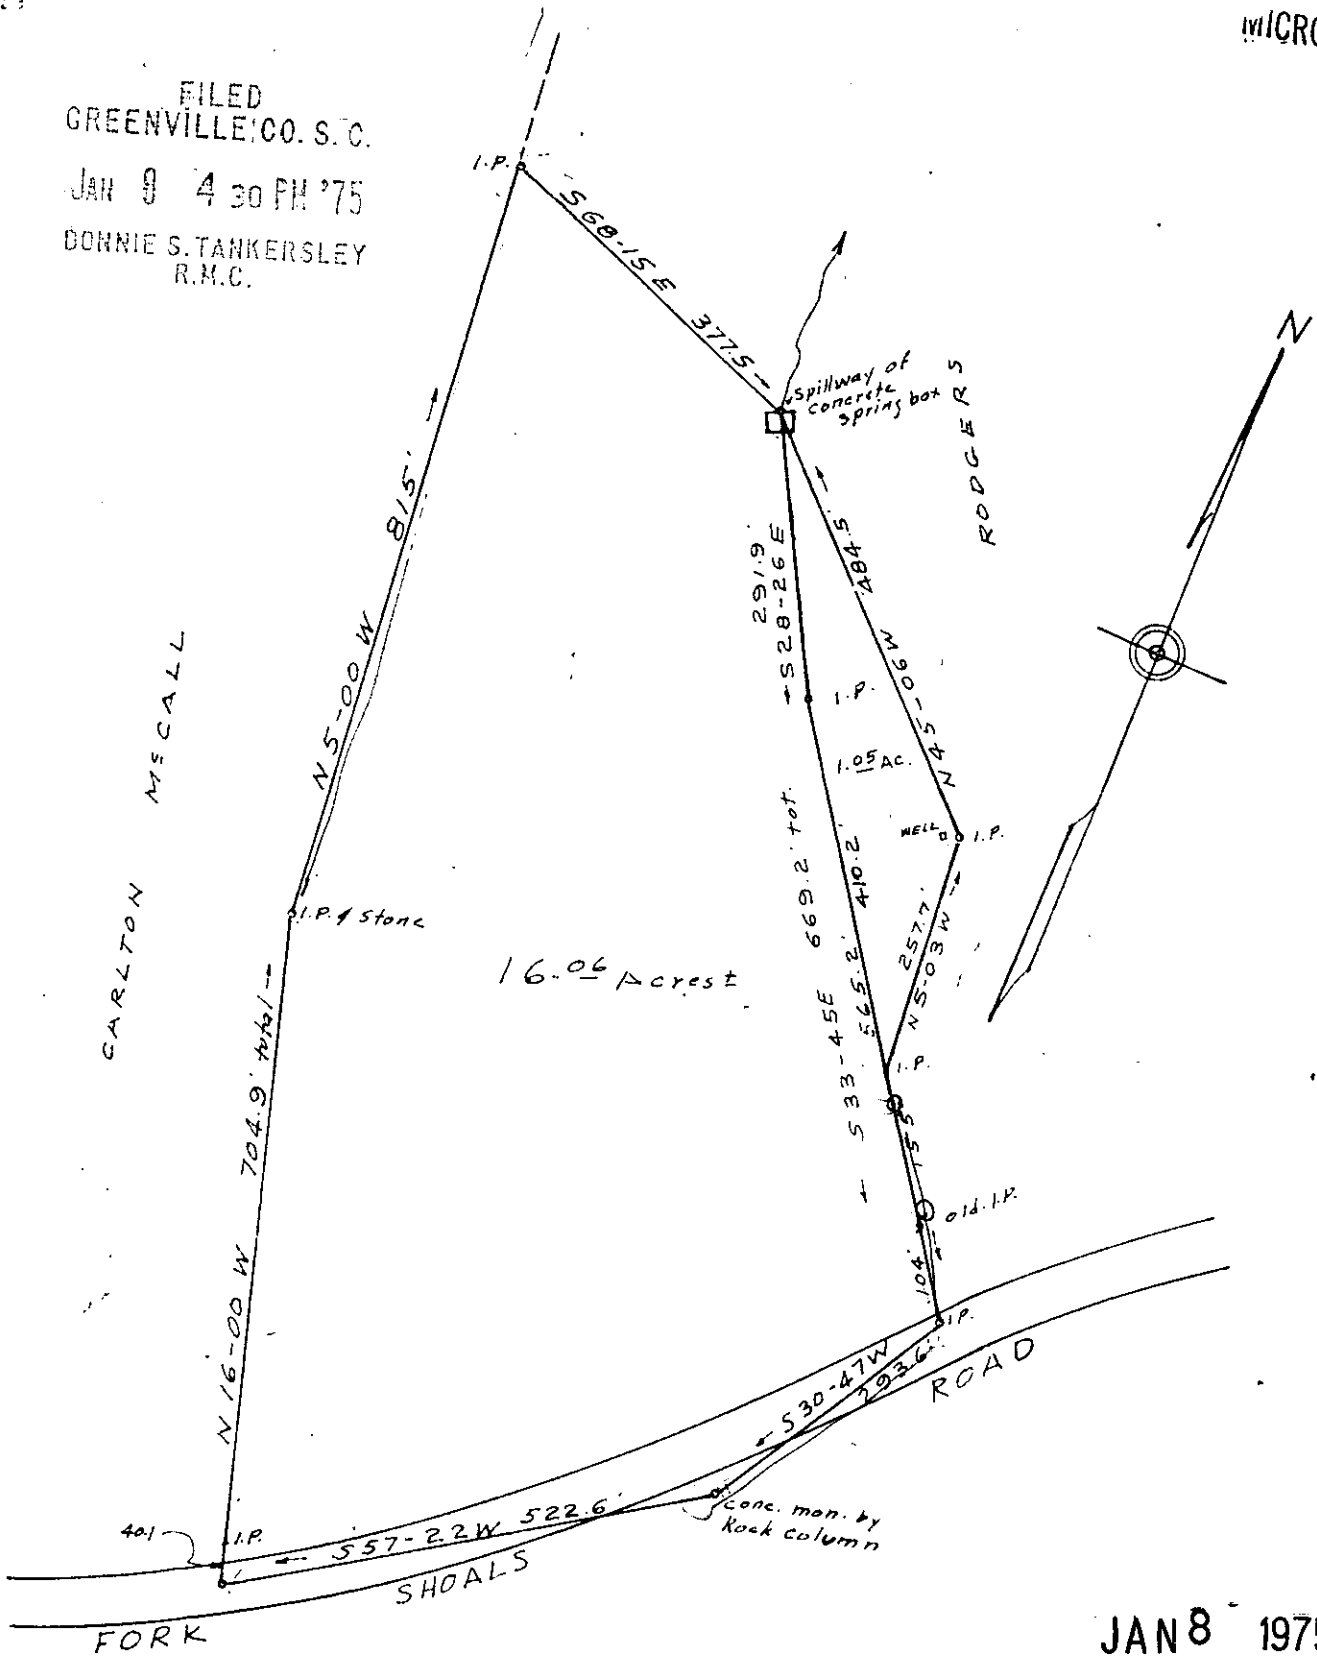

JAN 8 1975

✓ 5-K-27

NOTE: 1.05 Acre tract surveyed  
and plat revised 12/18/74

RECORDING FEE
PAID \$ 1.00

PROPERTY OF  
**FORK SHOALS BAPTIST CHURCH**  
 GREENVILLE COUNTY S.C.  
 SCALE 1"=200'

Members present at survey:  
 Wallace Higgs - Chair  
 Will Henderson  
 Clarence Williams  
 Carlton McCall



JUNE 1957  
16282

Field book B-56

C.O. Riddle - Reg. L.S.