


GREENVILLE CO. SCHOOLS

586-150

MICROFILMED

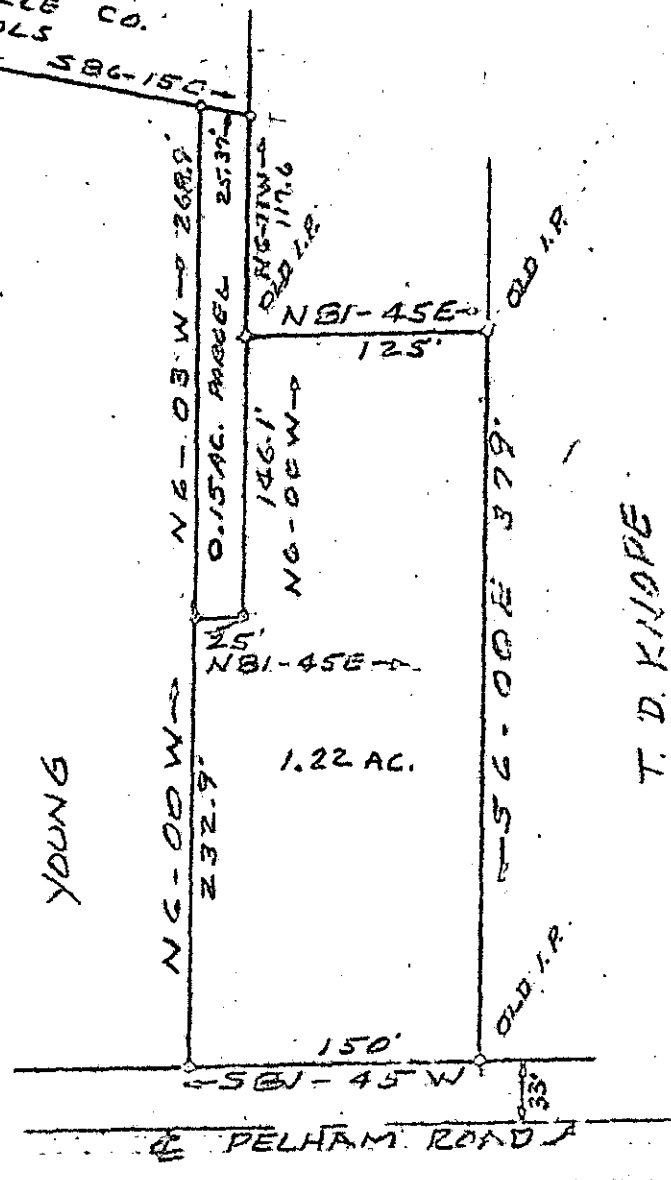

PROPERTY OF
 JAMES E. PARKHILL &
 SHIRLEY D. PARKHILL
 NEAR GREENVILLE, S.C.
 OCT. 17, 1972 SCALE 1" = 100'

FILED
 GREENVILLE CO. S.C.
 JUN 30 11 12 AM '77
 DONNIE S. TANKERSLEY
 R.H.C.

17905
 5-K-48



REVISED NOV. 4, 1979
 0.15 AC. PARCEL ADDED
 H.C. [Signature] 2509

SURVEY BY: CAMPBELL & CLARKSON
 SURVEYING & ENGINEERING, INC.
 D.C. [Signature]
 1015 N. W. 25th St.

RECORDING FEE
 PWD \$ 1.00