


MICROFILMED

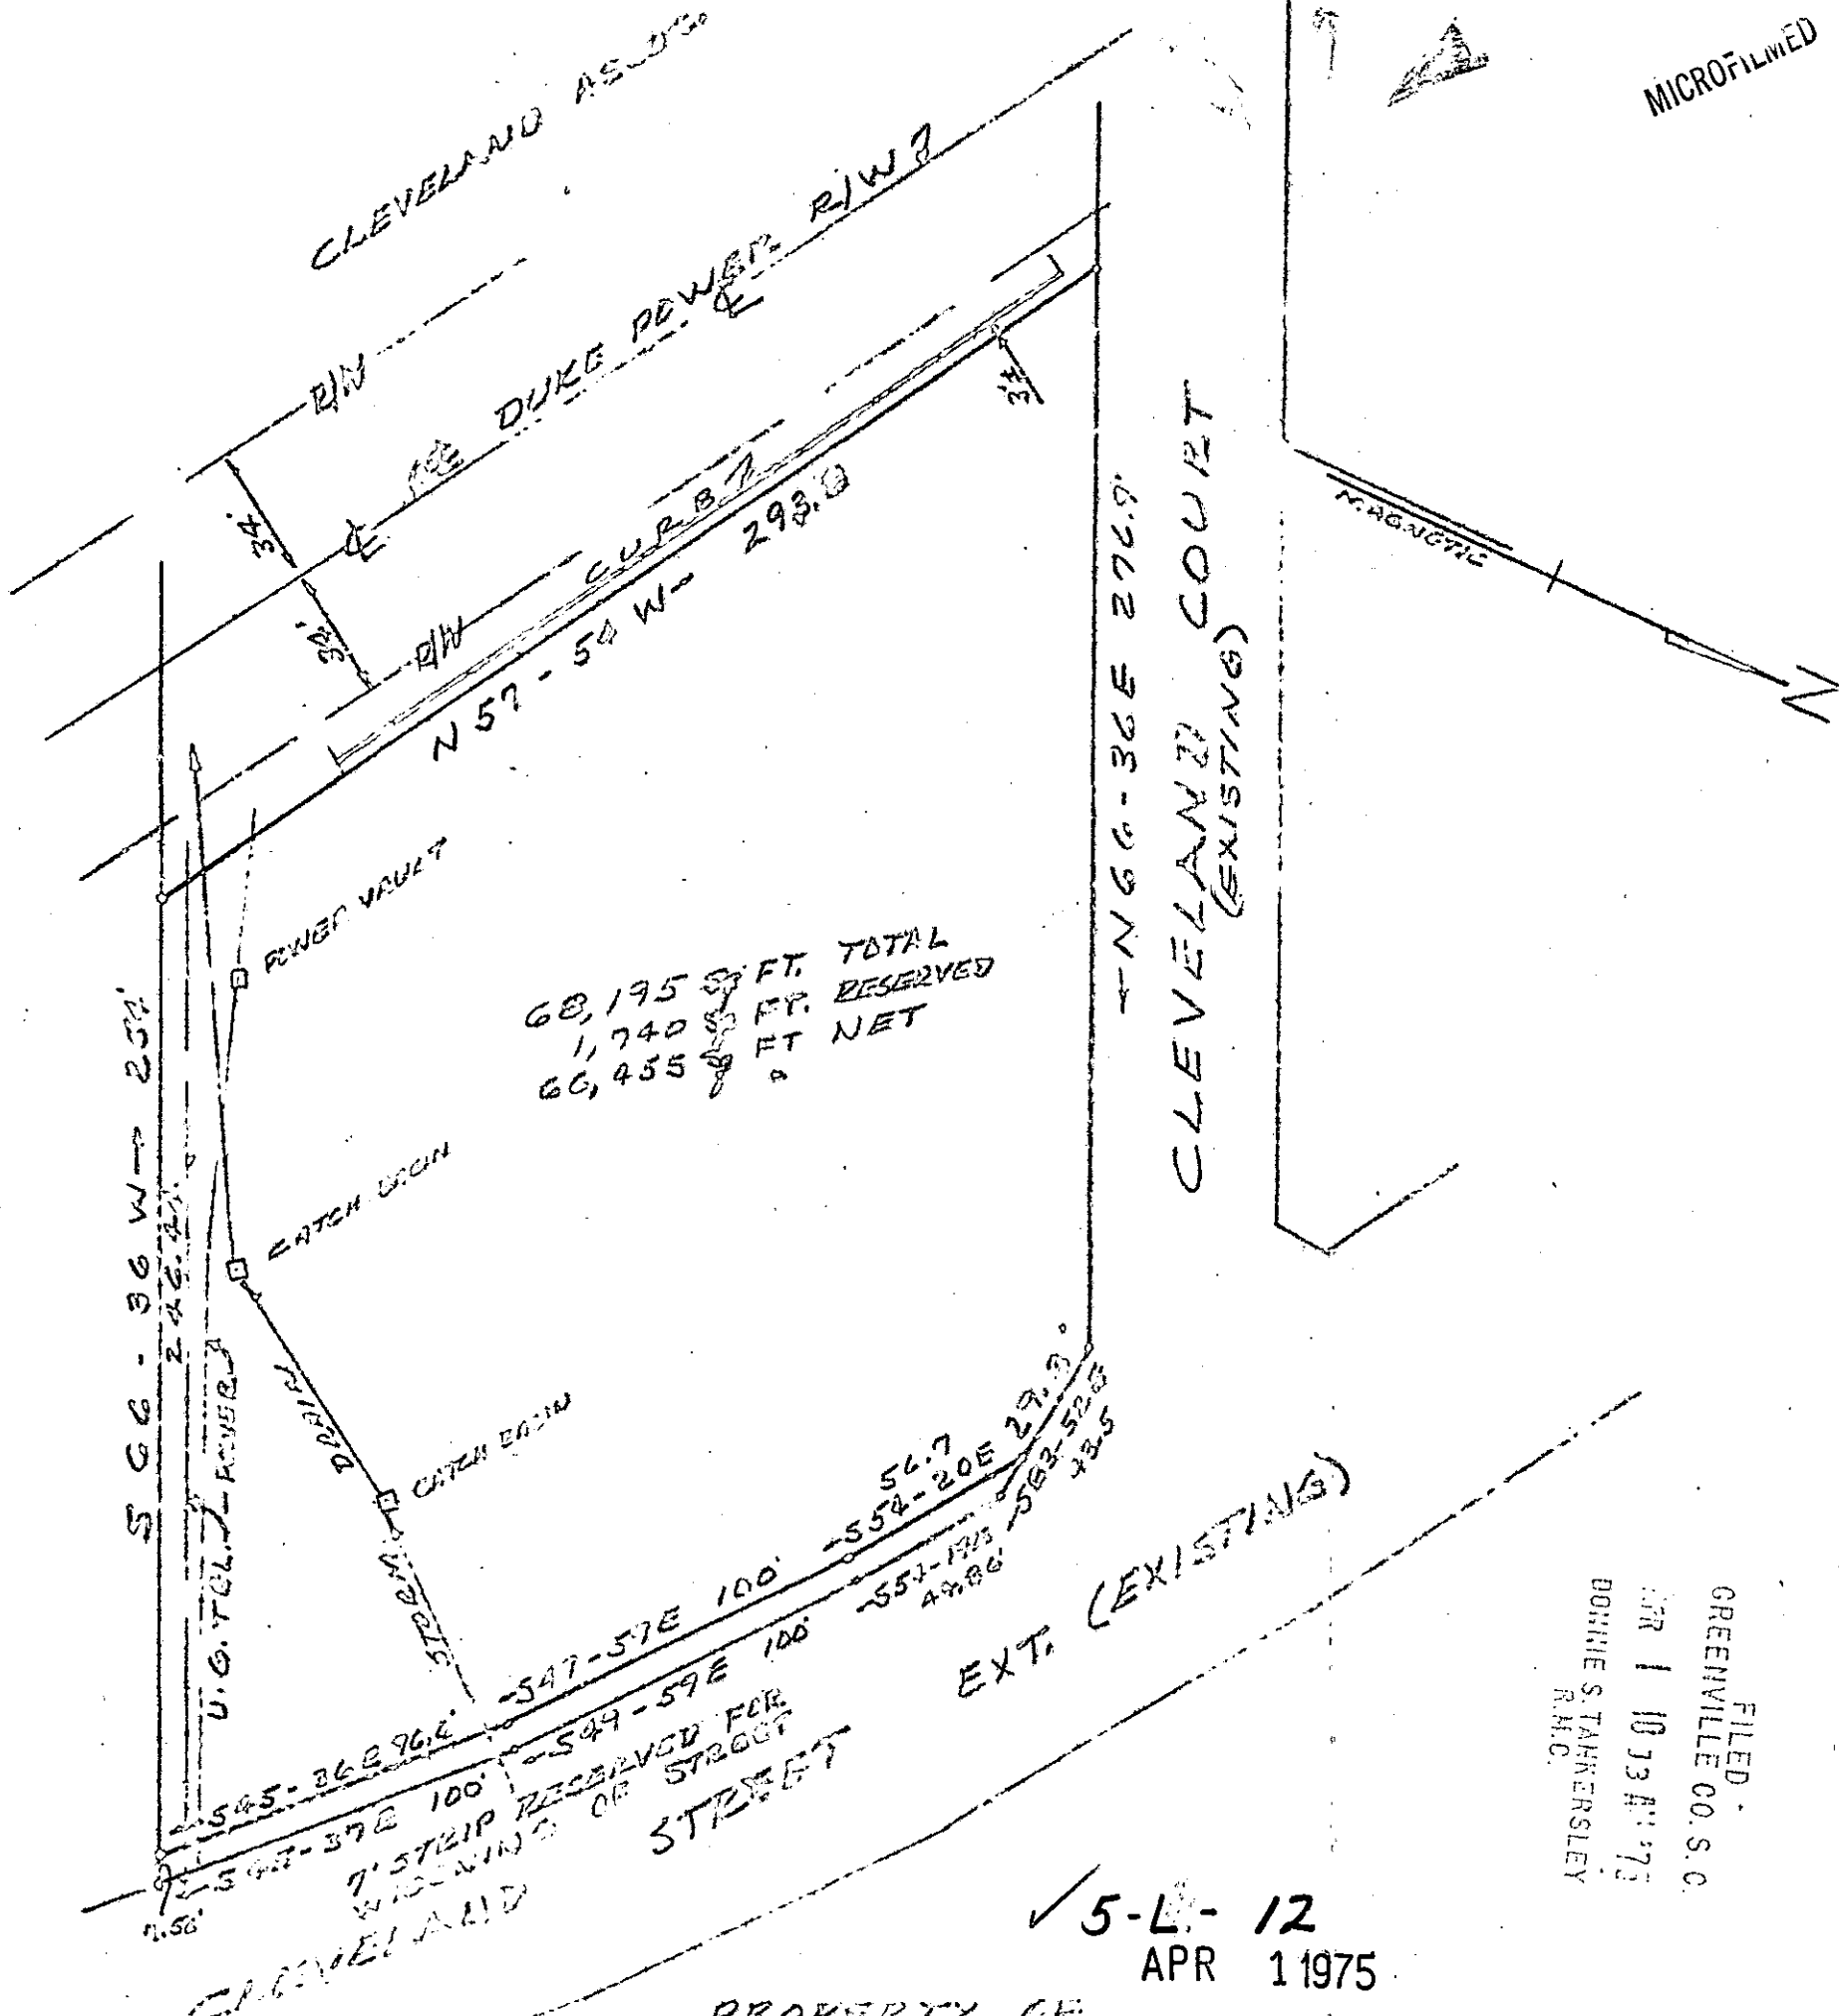

68,195 SQ. FT. TOTAL
 1,740 SQ. FT. RESERVED
 66,455 SQ. FT. NET

FILED
 GREENVILLE CO. S. C.
 APR 1 10 33 AM '75
 DONNIE S. TARKERSLEY
 R.M.C.

✓ 5-L-12
 APR 1 1975

PROPERTY OF
 PROFIT SHARING PLAN & TRUST
 OF ORTHODONTIC ASSOCIATES, P.A.
 GREENVILLE, S. C.

FEB. 12, 1975

SURVEY BY: N. C. [unclear]
 SCALE: AS SHOWN



22501

RECORDING FEE
 PAID \$ 2.00