


MICROFILMED

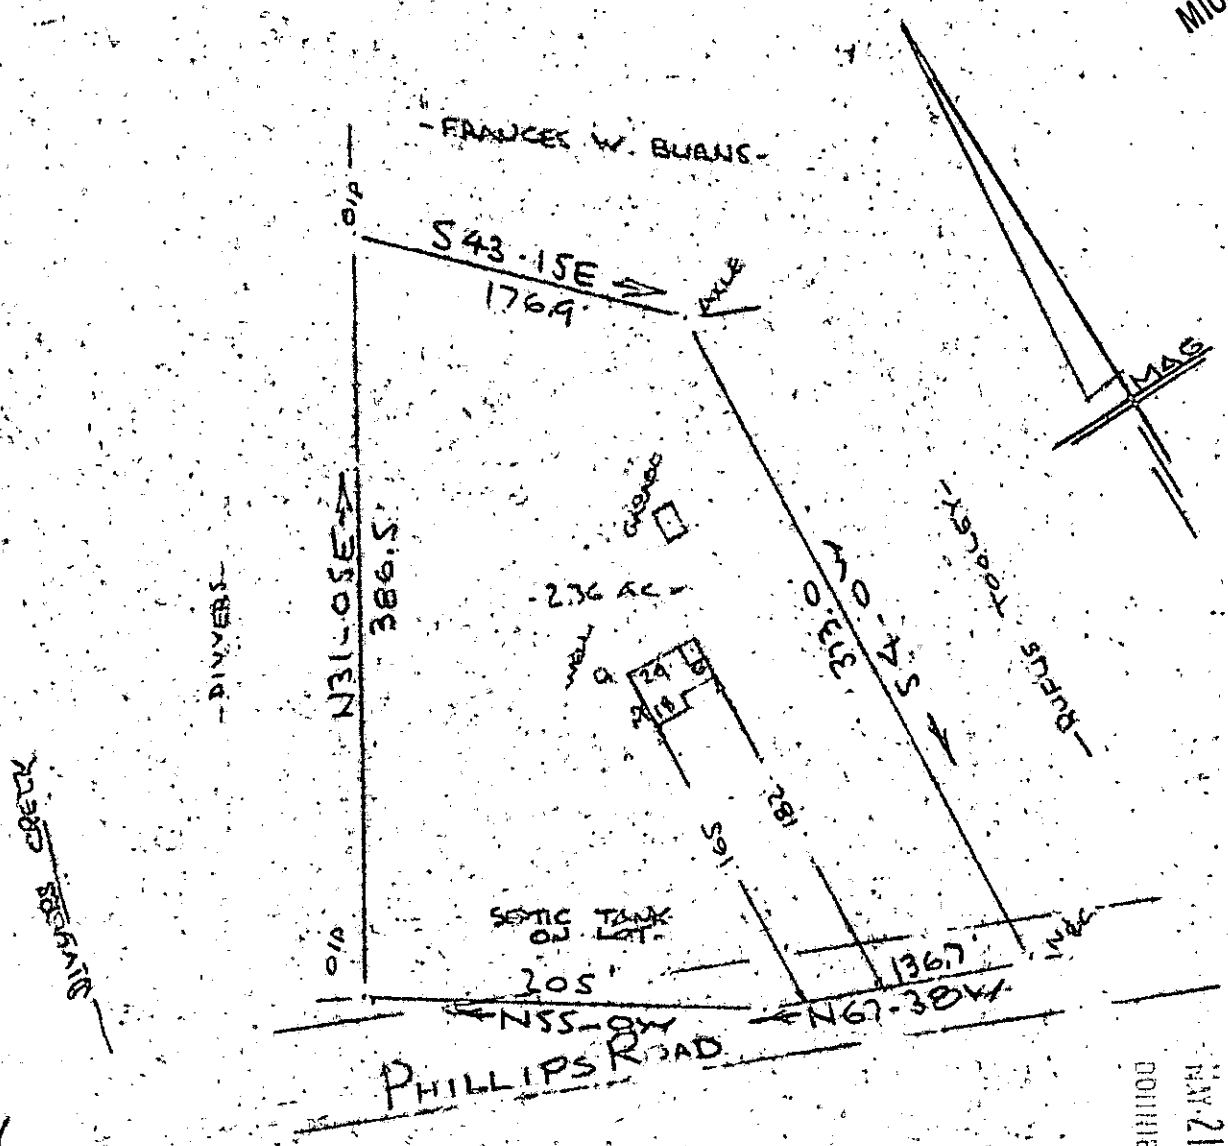

PROPERTY OF
LARRY STEVEN JONES
 NEAR GREENVILLE, S.C.
 SCALE: 1" = 100'

FILED
 GREENVILLE CO. S. C.
 MAY 21 3 49 PM '75
 DONNIE S. TARKENTLEY
 R.H.C.

This is to certify that on the 21st day of May, 1975, I surveyed the property shown on this, being known as PROPERTY OF LARRY STEVEN JONES and recorded in the RMC Office Greenville County, S. C., in Plat Book at Page ; and that the property lines, walls and buildings are as shown hereon, and that the walls and buildings located on said lot do not encroach or project on adjacent street or property, and that no adjacent walls or buildings encroach or project on said premises, and no power lines cross this property except as shown hereon.

SOUTH CAROLINA REGISTERED
 NO. 1952
 R. B. BRUCE
 27175

✓ 5m-24

GAROLINA SURVEYING CO.
 112 Manly St.
 Greenville, S. C.

1.00