
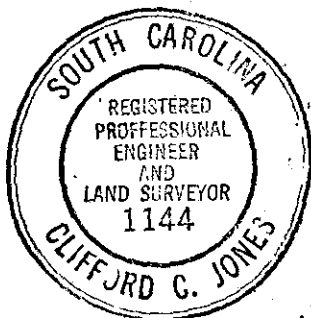
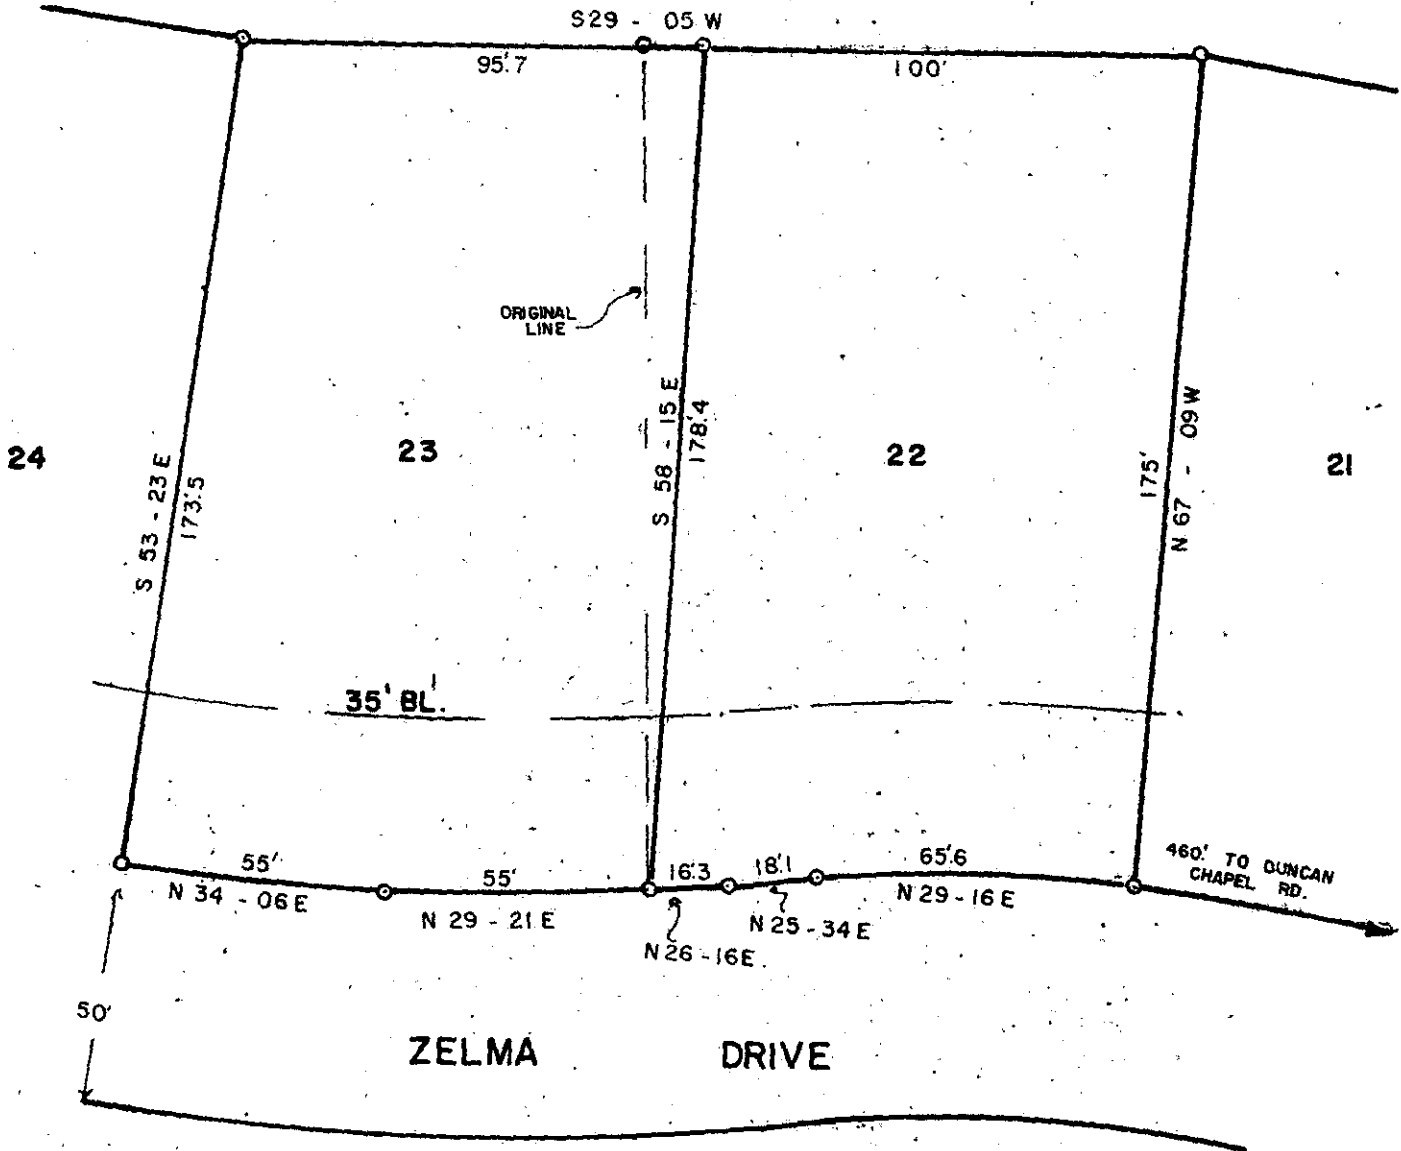


MICROFILMED

FILED  
GREENVILLE CO. S. C.  
JUN 11 3 43 PM '75  
DONNIE S. TANKERSLEY  
R.M.C.

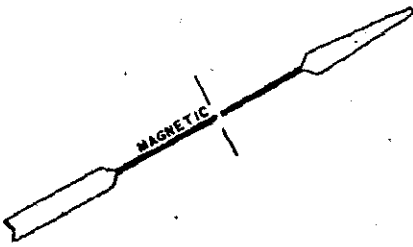

REVISION OF  
**LOTS 22 & 23**  
**OAKLAND TERRACE**  
GREENVILLE, COUNTY, S. C.  
SCALE 1" = 40'      NOV. 6, 1973

29217

✓ 5M-59

RECORDING FEE  
PAID \$ 1.00