


MICROFILMED

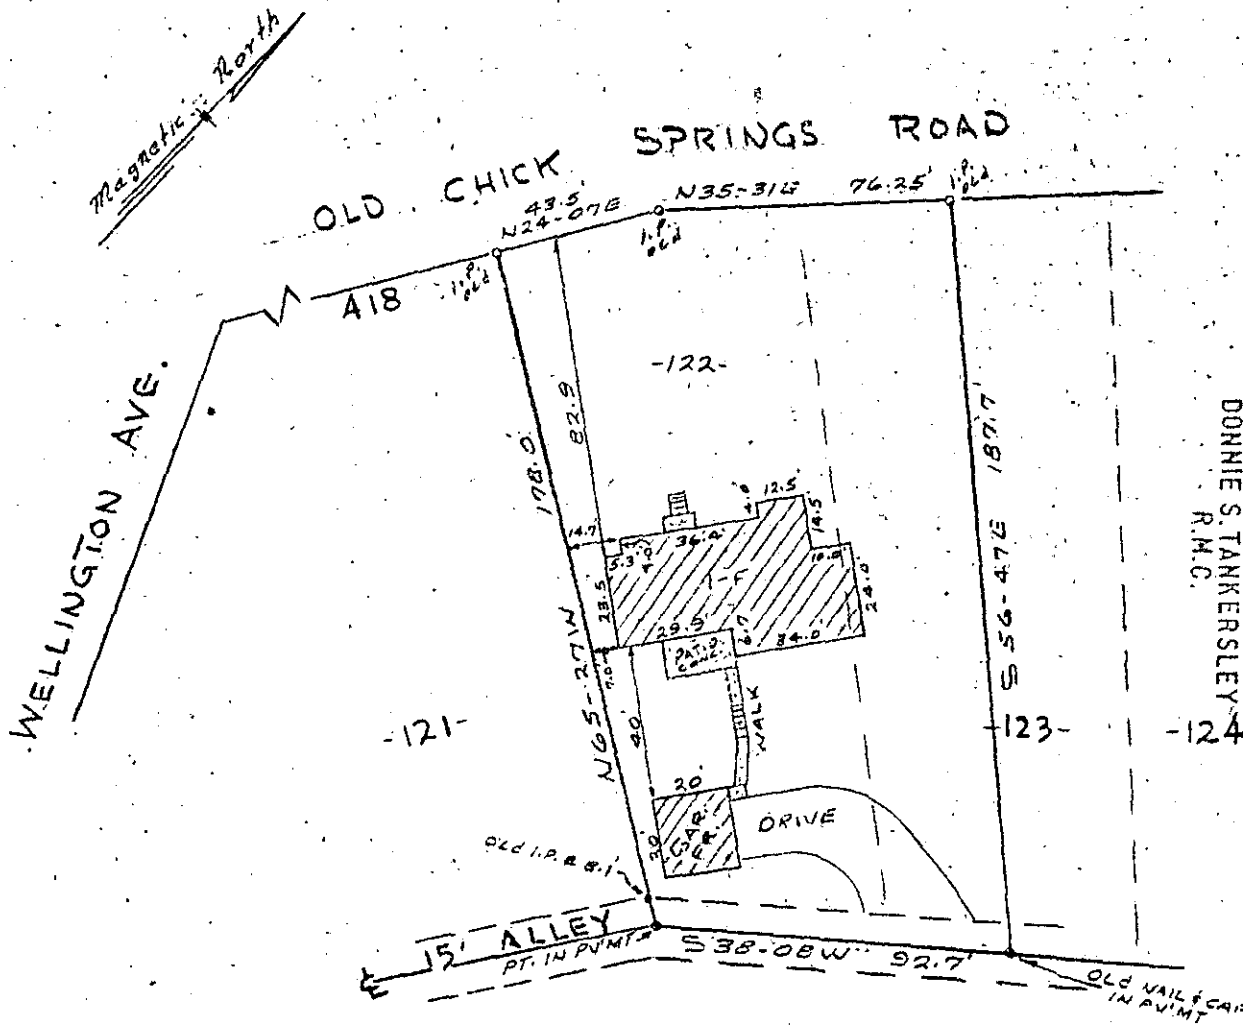

FILED  
 GREENVILLE CO. S. C.  
 JUN 17 10 30 AM '75  
 DONNIE S. TANKERSLEY  
 R.M.C.

SURVEY FOR  
PATRICK M. JANSEN  
 Lot No. 122 & 1/2 Lot No. 123 VISTA HILLS  
 GREENVILLE, S.C.  
 SCALE 1"=50' JUNE 12, 1975

29815

This is to certify that on the 12th day of June, 1975, I surveyed the property shown on this plat and that the property lines, walls and buildings are as shown hereon; that the buildings located on said lot do not encroach or project on adjacent streets or property; that no adjacent walls or building encroach or project on this lot and that there are no utility lines crossing this property except as shown.

✓ 5 m - 6.5

*Aaron M. Thompson*  
 Registered Land Surveyor No. 3616  
 SOUTH CAROLINA REGISTERED LAND SURVEYOR  
 AARON M. THOMPSON

RECORDING FEE  
 PAID \$ 1.00

PIEDMONT ENGINEERS - ARCHITECTS - PLANNERS  
 GREENVILLE, S. C.