
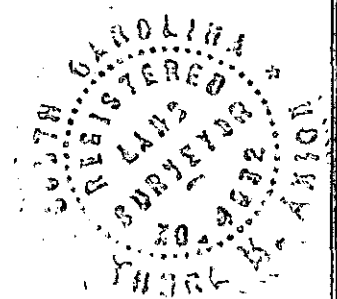
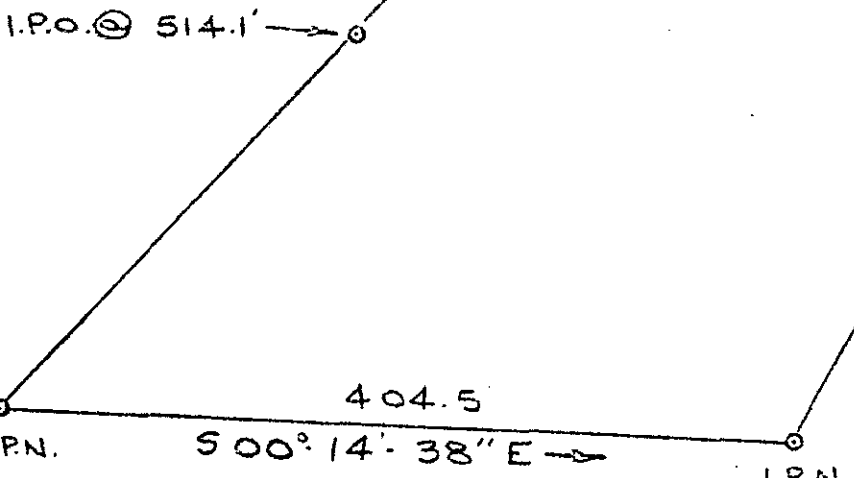
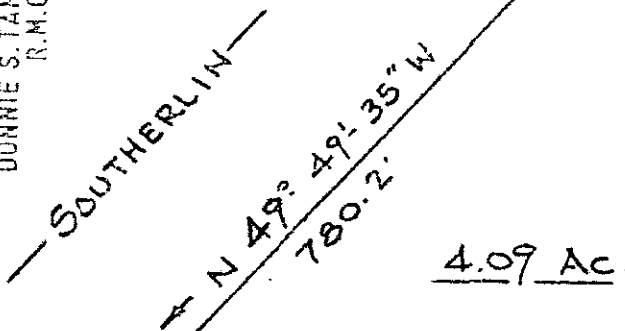



MICROFILMED

FILED
 GREENVILLE CO. S.C.
 AUG 12 8 47 AM '75
 DONNIE S. TANKERSLEY
 R.M.C.

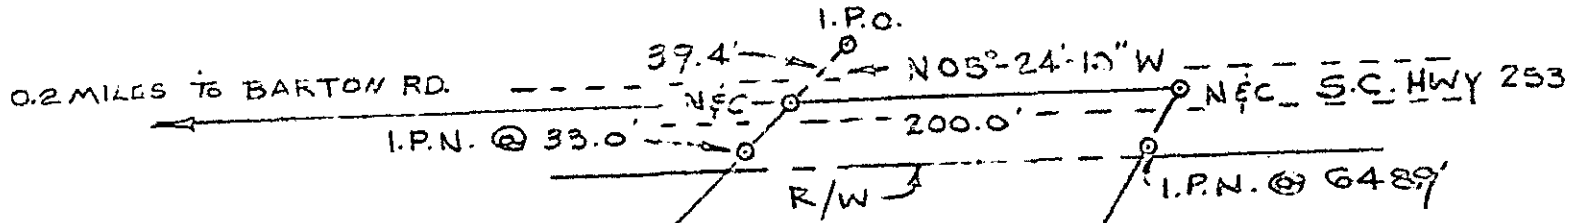

STATE OF SOUTH CAROLINA
 COUNTY OF GREENVILLE
 APPROX. 1.5 MILES NORTH
 OF TYGERVILLE

3824
 5m-139

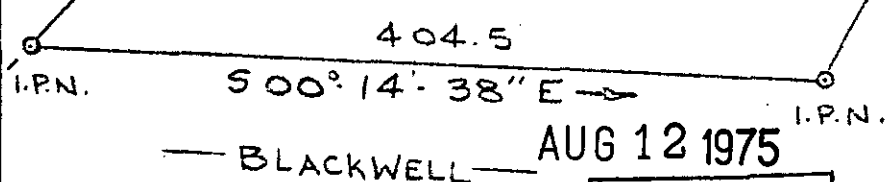

AUG 12 1975
 RECORDING FEE
 PAID \$ 1.00

REVISIONS			SURVEY FOR		
NO.	DATE	BY	ROBERT W. & SUSAN E. BLACKWELL		
1			SURVEY MADE BY: THOMAS D. LINDSEY		
2			APPROVED BY: THURL M. AMICK R.L.S. #4022		
3			DRAWN BY T.M.A.	SCALE 1" = 100'	MATERIAL
4			CHK'D T.D.L.	DATE 8-6-75	DRAWING NO.
5			TRACED	APP'D T.M.A.	