


PROPERTY OF  
**GEORGE H. KOHLER JR**  
 NEAR GREENVILLE, S.C.  
 SCALE 1" = 40'      28 AUG 1975

This is to certify that on the 28th day of August 1975, I surveyed the property shown on this plat, being known as PROPERTY OF GEORGE H. KOHLER, JR. and recorded in the RMC Office Greenville County, S. C., in Plat Book at Page ; and that the property lines, walls and buildings are as shown hereon, and that the walls and buildings located on said lot do not encroach or project on adjacent street or property, and that no adjacent walls or buildings encroach or project on said premises, and no power lines cross this property except as shown hereon.

FILED  
 GREENVILLE CO. S.C.  
 SEP 3 12 01 PM '75  
 DONNIE S. TANKERSLEY  
 R.M.C.

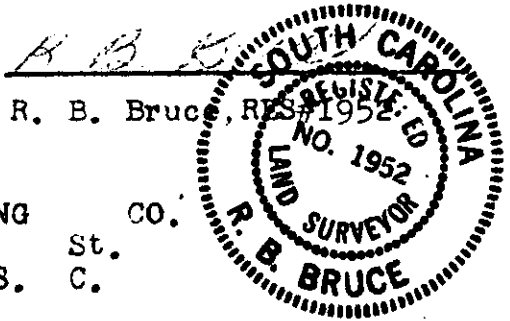

R. B. Bruce, RES. #1952

SEP 3 1975

CAROLINA SURVEYING CO.  
 112 Manly St.  
 Greenville, S. C.

√ 5 N - 10

RECORDING FEE  
 PAID \$ 1.00

5921