


FILED
 GREENVILLE, CO. S. C.
 DEC 3 3 37 PM '75
 DONNIE S. TANKERSLEY
 R.H.C.

PROPERTY OF
ROBERT L. MCGINNIS & ELIZABETH H. MCGINNIS
 GREENVILLE, SOUTH CAROLINA
 SCALE 1" = 60' 21NOV1975

This is to certify that on the 21st day of November 1975, I surveyed the property shown on this plat, being known as Part of lot 3 & part of 5 on a plat of MRS. MELVILLE WESTERVELT, et al and recorded in the RMC Office Greenville County, S. C., in Plat Book "J" at Page 13; and that the property lines, walls and buildings are as shown hereon, and that the walls and buildings located on said lot do not encroach or project on adjacent street or property, and that no adjacent walls or buildings encroach or project on said premises, and no power lines cross this property except as shown hereon.

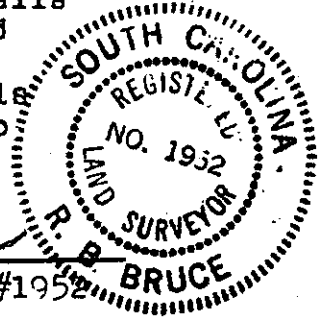

R. B. Bruce
 R. B. Bruce, RLS #1952

5N-131
 RECORDING FEE
 PAID \$ 1.00

14496

DEC 3 - 1975

CAROLINA SURVEYING CO.