


REF. SEE PLAT FOR FRANK TOWERS RICE FILED IN PLAT BK. RRR PAGE 89.

FILED
GREENVILLE CO. S. C.

Nov 18 3 26 PM '75

DONNIE S. TANKERSLEY
R.M.C.

MICROFILMED

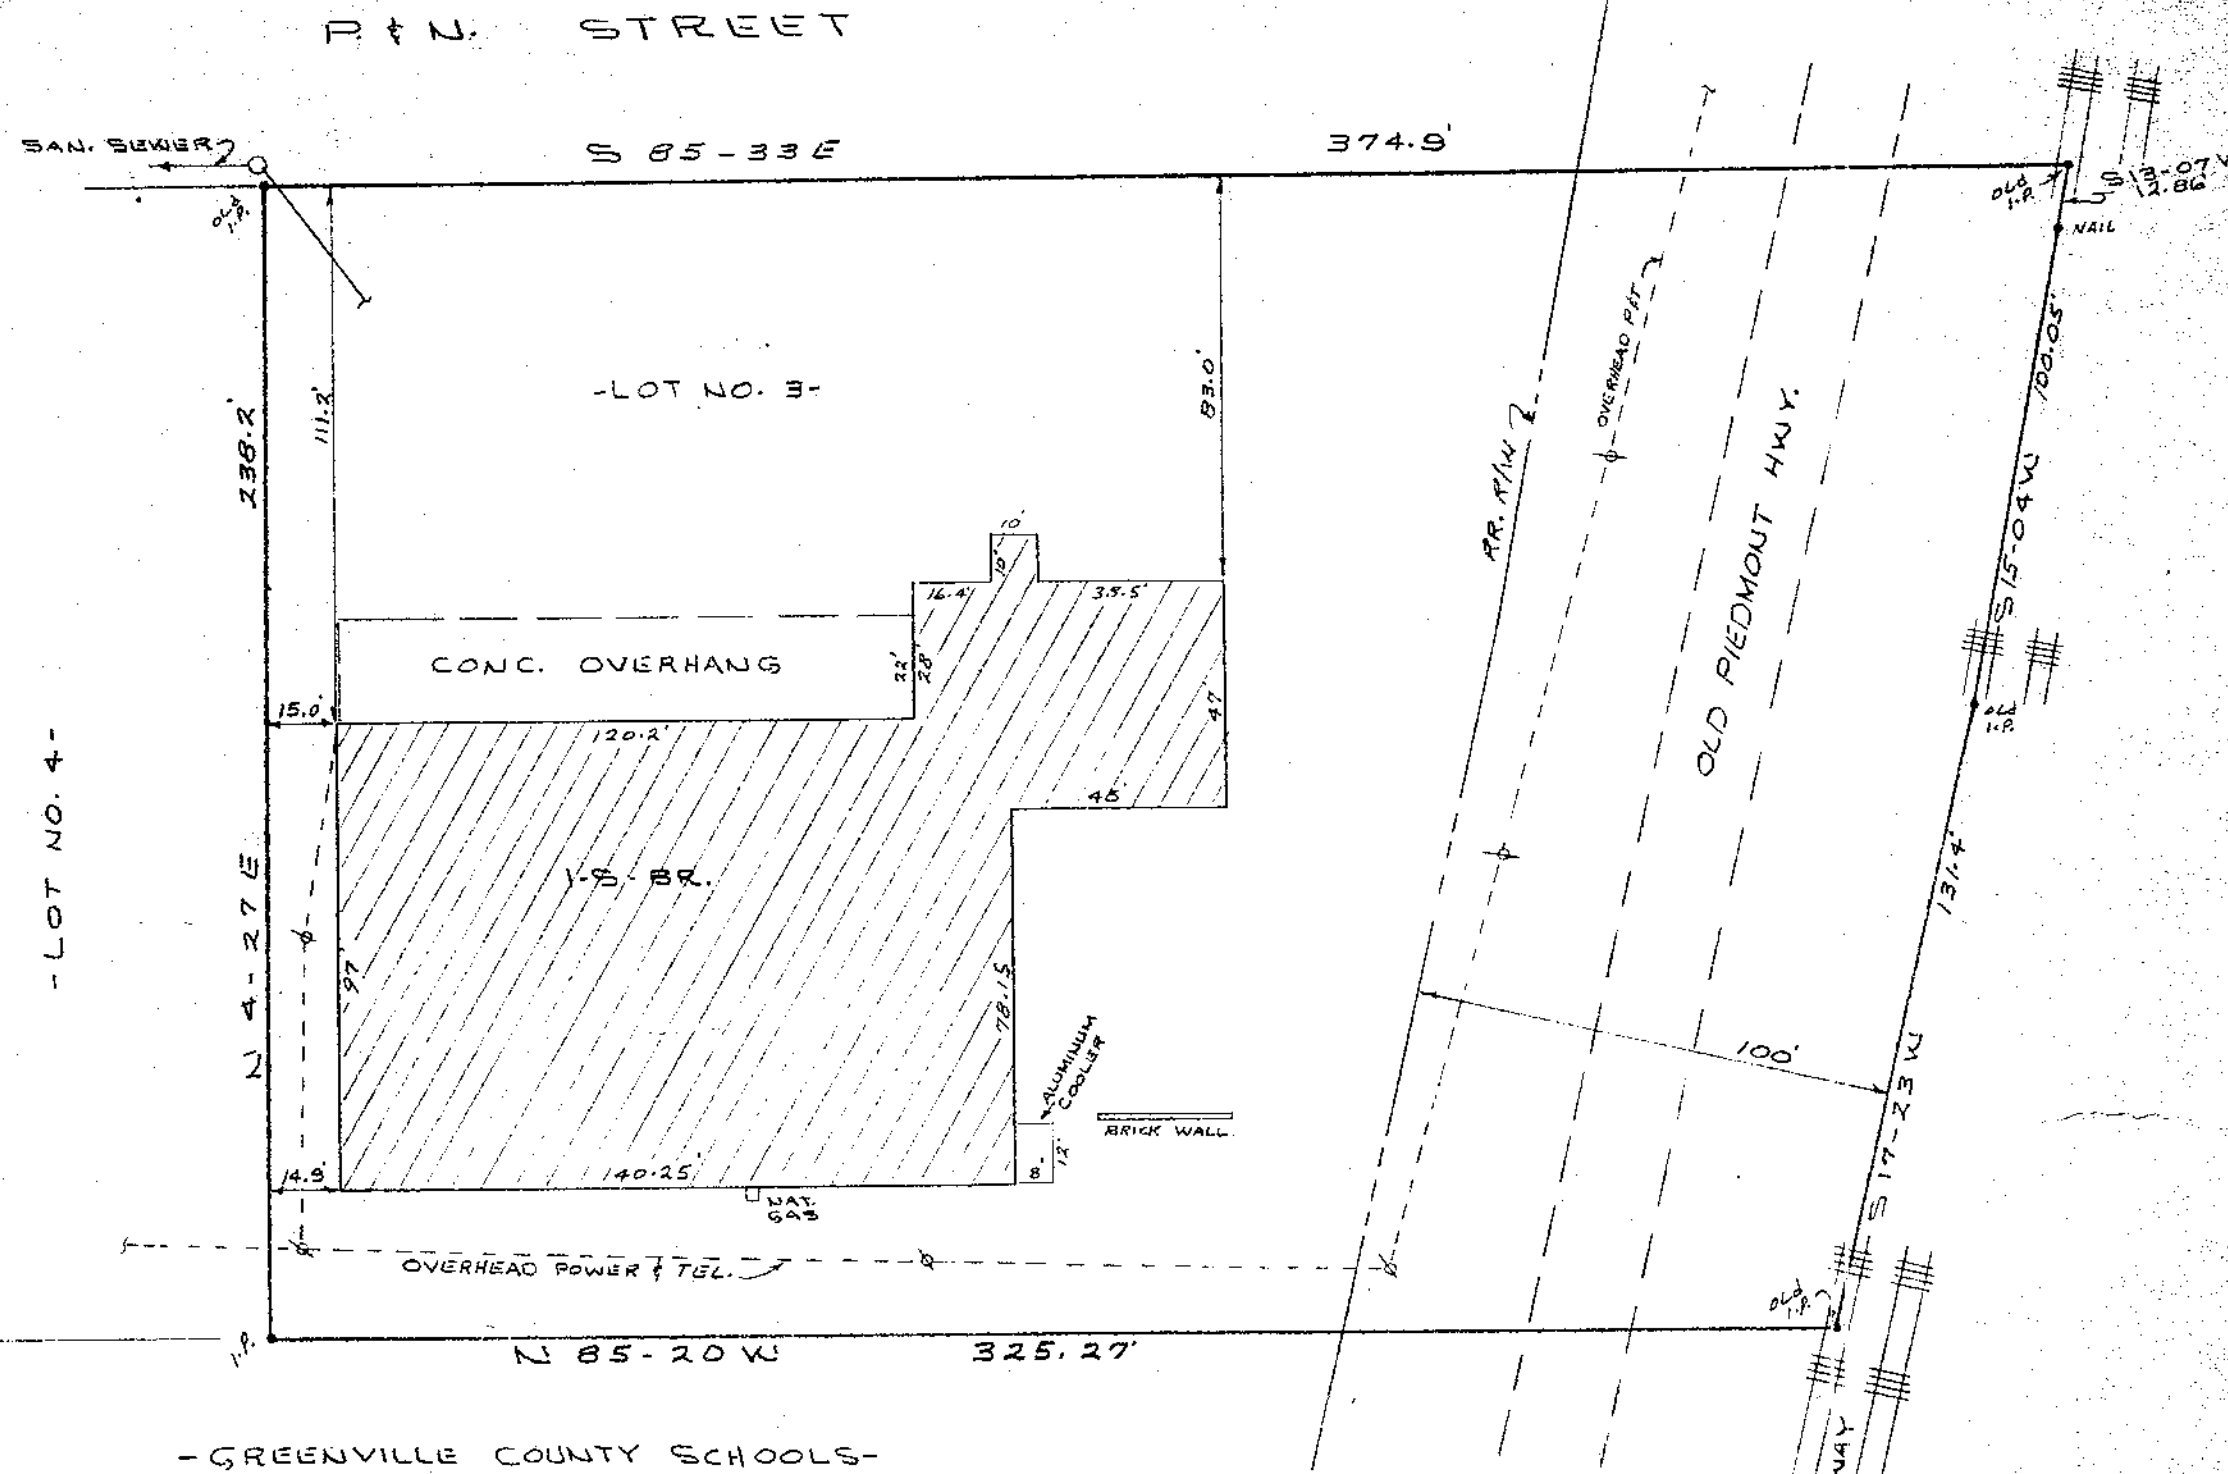

SURVEY FOR
CANTEEN OF DIXIE, INC.
 GREENVILLE CO., S. C.
 SCALE 1" = 40' - NOV. 17, 1975

I CERTIFY THAT THE ABOVE SURVEY
 IS CORRECTLY REGISTERED
 IN THE PUBLIC RECORDS
 OF GREENVILLE COUNTY, S. C.
 THIS LAND SURVEY NO. 3616
 No. 3616
 LAND SURVEYOR
 ARON M. THOMPSON

PIEDMONT ENGINEERS-ARCHITECTS-PLANNERS
 GREENVILLE, SOUTH CAROLINA

15-0-11

13236
 NOV 18 1975

RECORDING FEE
 PAID \$ 6.00

MIC 10-1-3-1.7