


FILED
 GREENVILLE CO. S. C.
 JAN 13 2 20 PM '76
 DONNIE S. TANKERSLEY
 R.M.C.


MICROFILMED

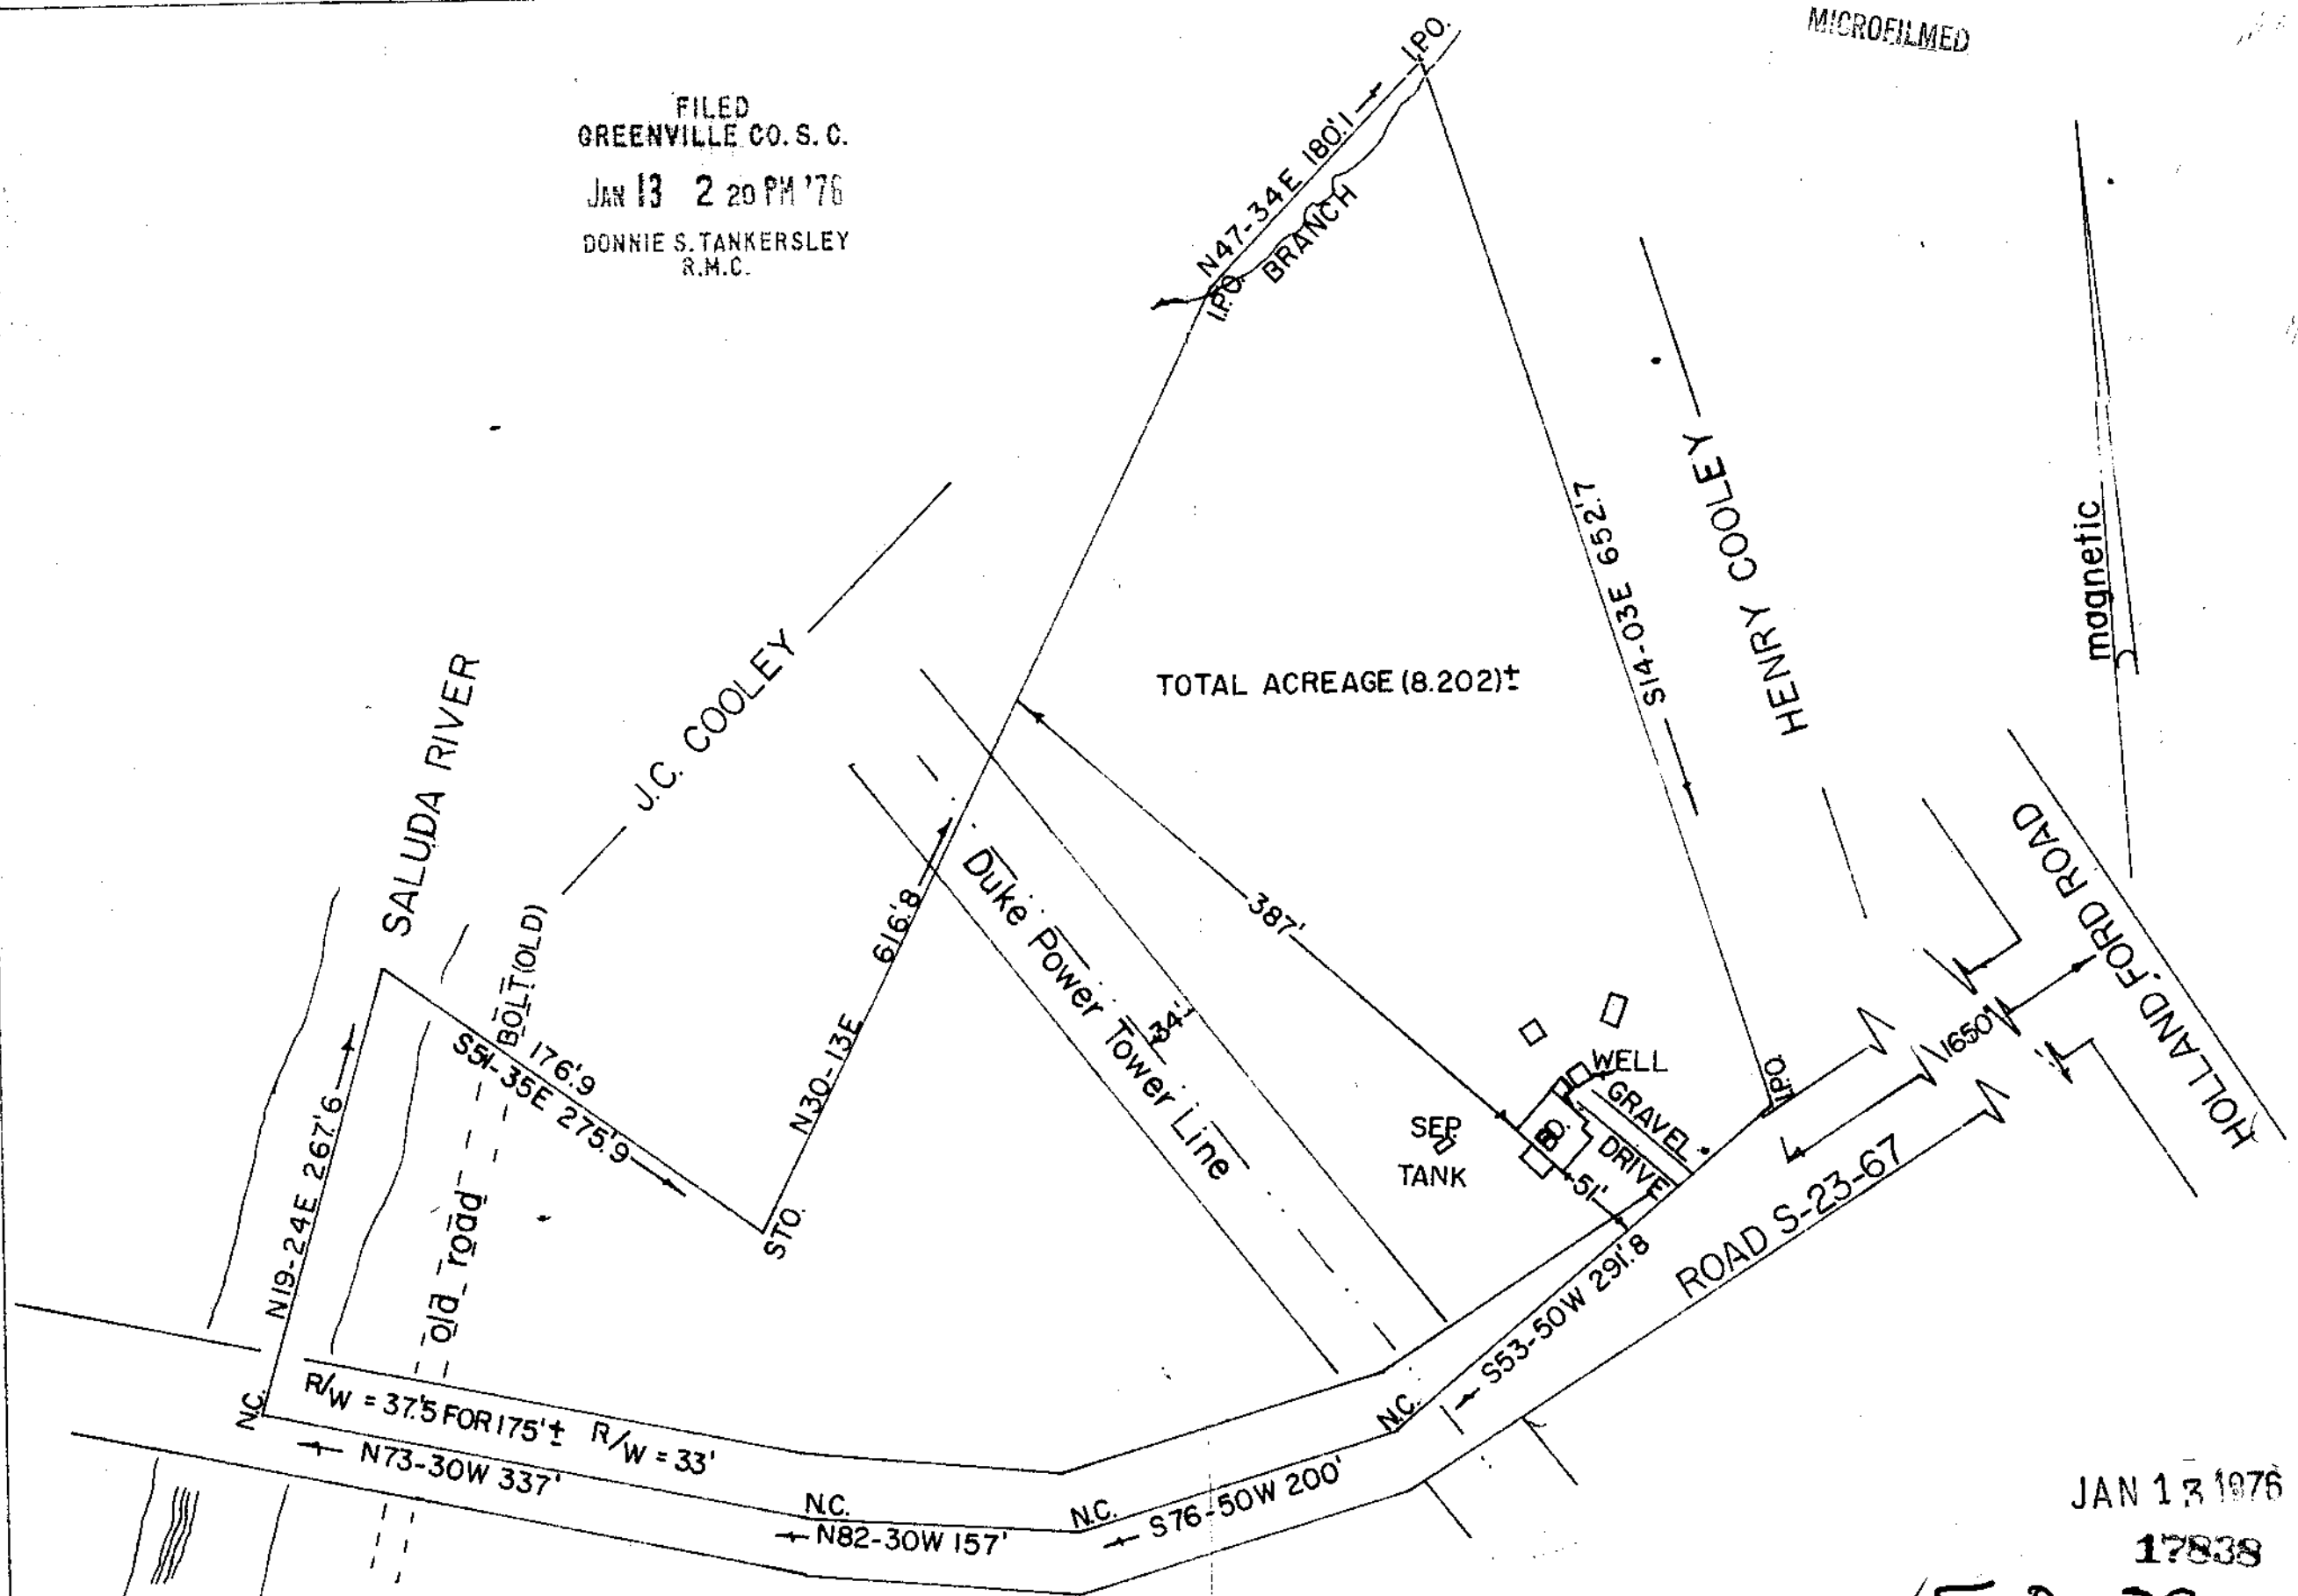

JAN 13 1976

17838

✓ 5-0-38

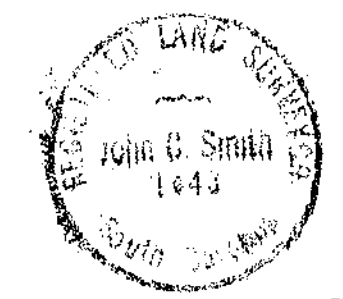

STATE OF SOUTH CAROLINA
 COUNTY OF GREENVILLE
 PROPERTY OF CHARLES WILFORD WHITE AND DELORCE P. WHITE
 THIS IS TO CERTIFY THAT ON THE 5th DAY OF JANUARY, 1976 I DID SURVEY THE PROPERTY SHOWN HEREON;
 THAT THE BUILDINGS, WALLS, AND LINES ARE AS SHOWN; THAT THIS BEING THE SAME PROPERTY AS SHOWN ON
 PLAT RECORDED IN THE CLERK OF COURTS OFFICE FOR GREENVILLE COUNTY AS RECORDED IN PLAT BOOK
 AT PAGE _____; THAT THIS PROPERTY DOES NOT ENCRANCH OR PROJECT ON ADJACENT PROPERTYS AND NO
 ADJACENT PROPERTYS ENCRANCH OR PROJECT ON THESE PREMISES, OTHER THAN RIGHTS OF WAYS.

JOHN G. SMITH
 REG. L.S. NO. 1643

RECORDING FEE
 PAID \$ 2.00

1" = 100'