

CARROLL B. WADDELL

FILED GREENVILLE CO. S. C.

JAN 30 4 36 PM '76

DONNIE S. TANKERSLEY R.M.C.

N 60° 30' E 435.8'


2.29 ACRES

LOT 8

MICROFILMED

LOT 9

BLAIR ESTATES

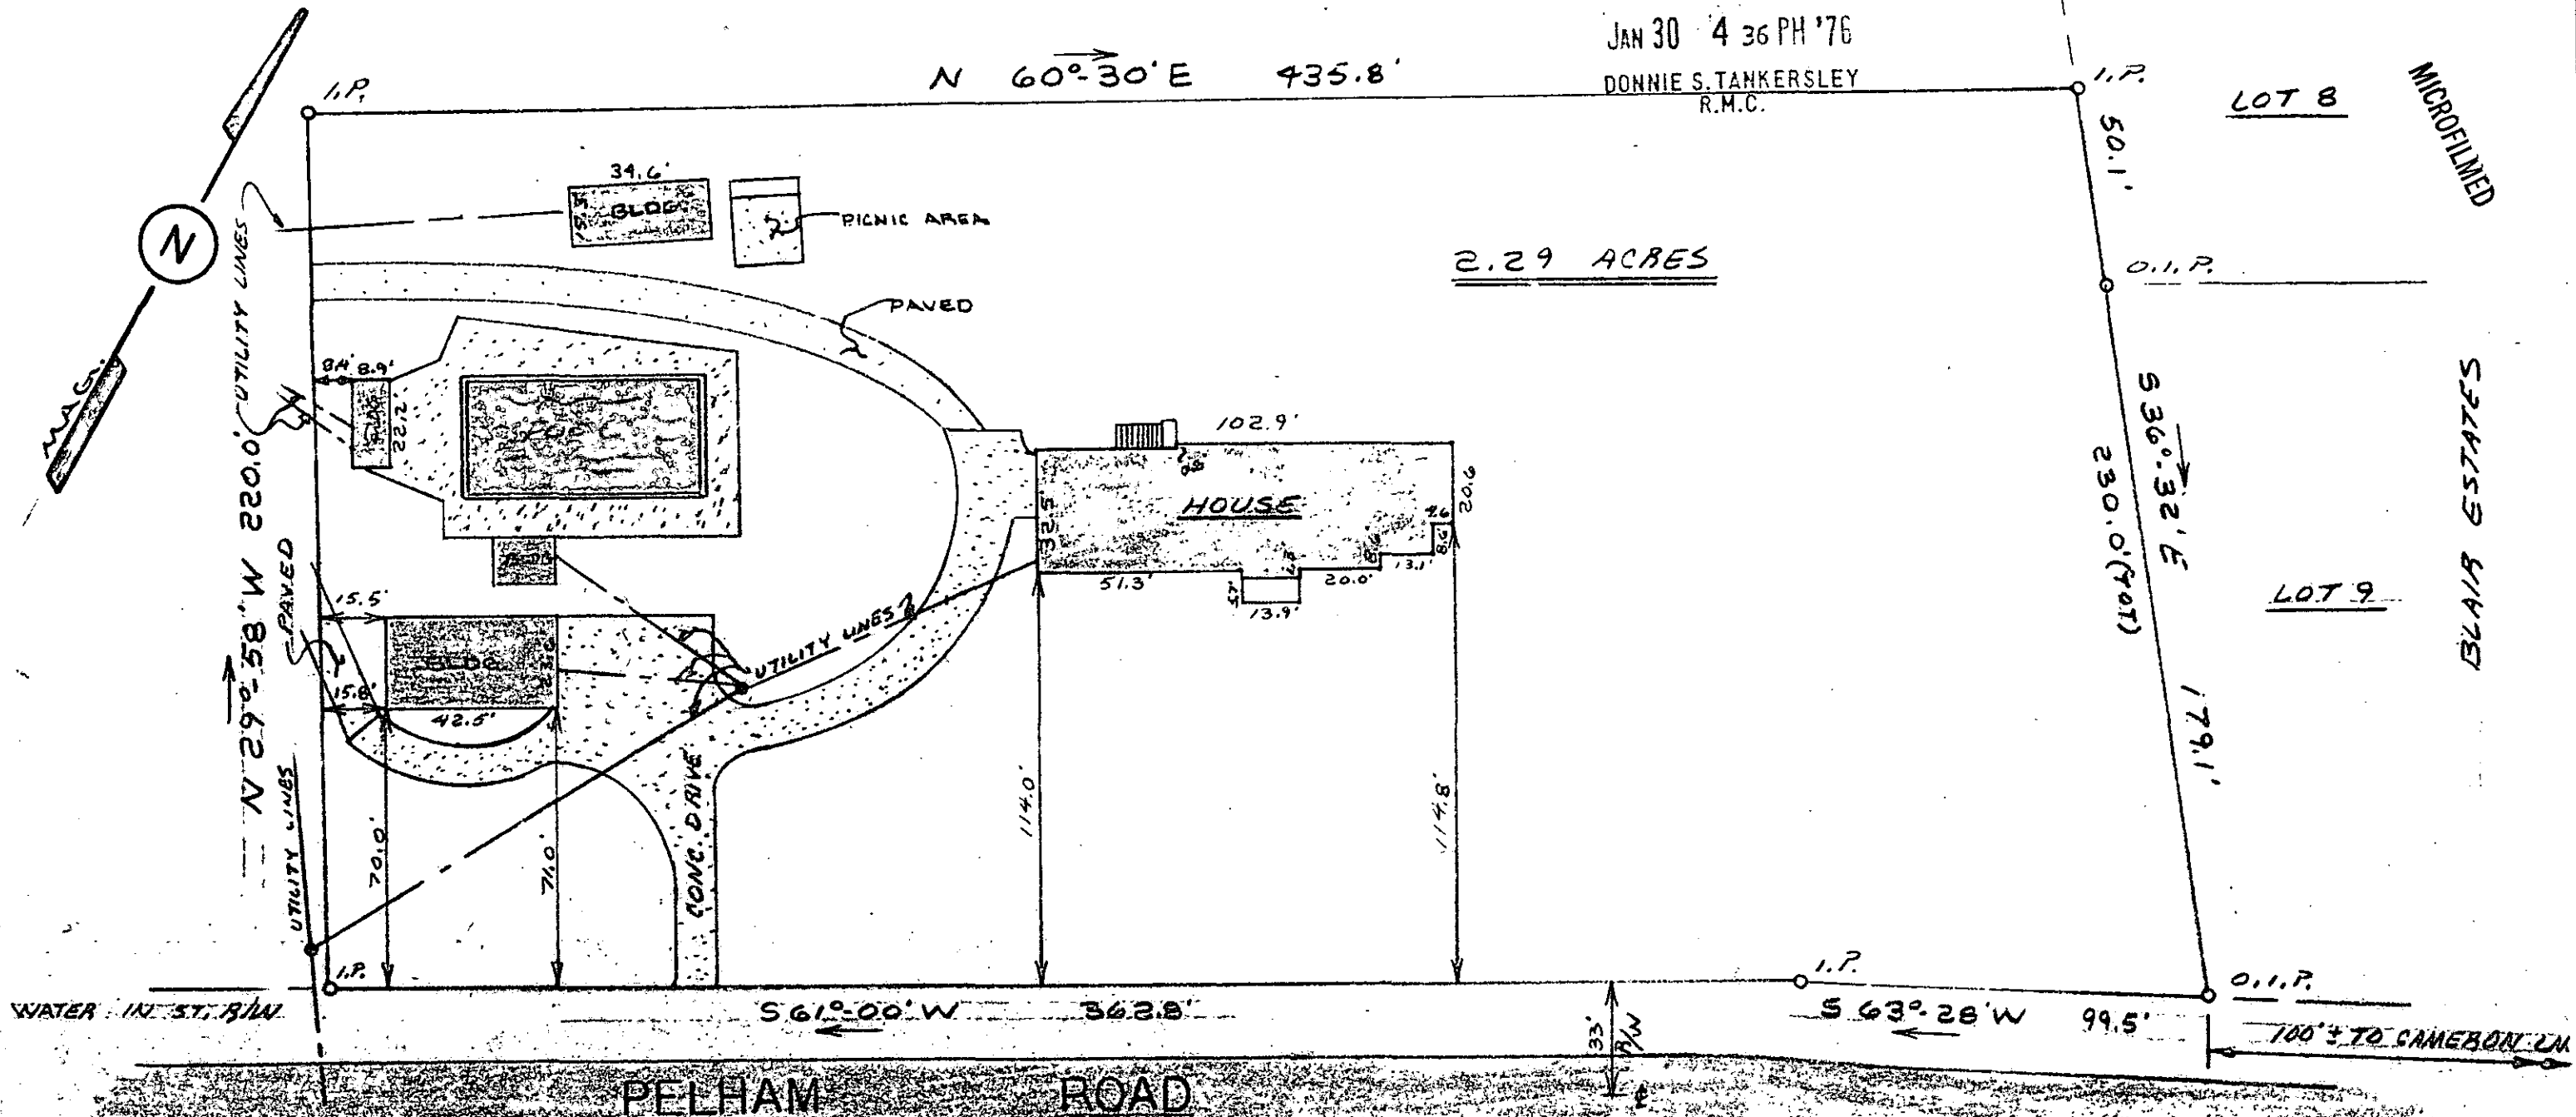

This is to certify that on January 28, 1976, I surveyed the property shown on this plat, known as a portion of the Carroll B. Waddell Property, recorded in the R.M.C. Office of Greenville County in Plat Book \_\_\_\_\_ on Page \_\_\_\_\_, and that the property lines, walls and buildings are as shown hereon; that the building located on said lot does not encroach or project on adjacent streets or property, and that no adjacent walls or buildings encroach or project on said premises, and that no utility lines cross this property except as shown hereon.

19449 *James R. Freeland*  
 James R. Freeland R.L.S. & P.E. 4781



RECORDING FEE PAID \$ *2.00*

JAN 30 1976

✓ 5-0-44

STATE OF SOUTH CAROLINA COUNTY OF GREENVILLE	
SCALE: 1" = 40'	APPROVED BY:
DATE: 1-28-76	DRAWN BY: FEL
PROPERTY OF CARROLL B. WADDELL	
Freeland & Associates	DRAWING NUMBER 76-804