


MICROFILMED

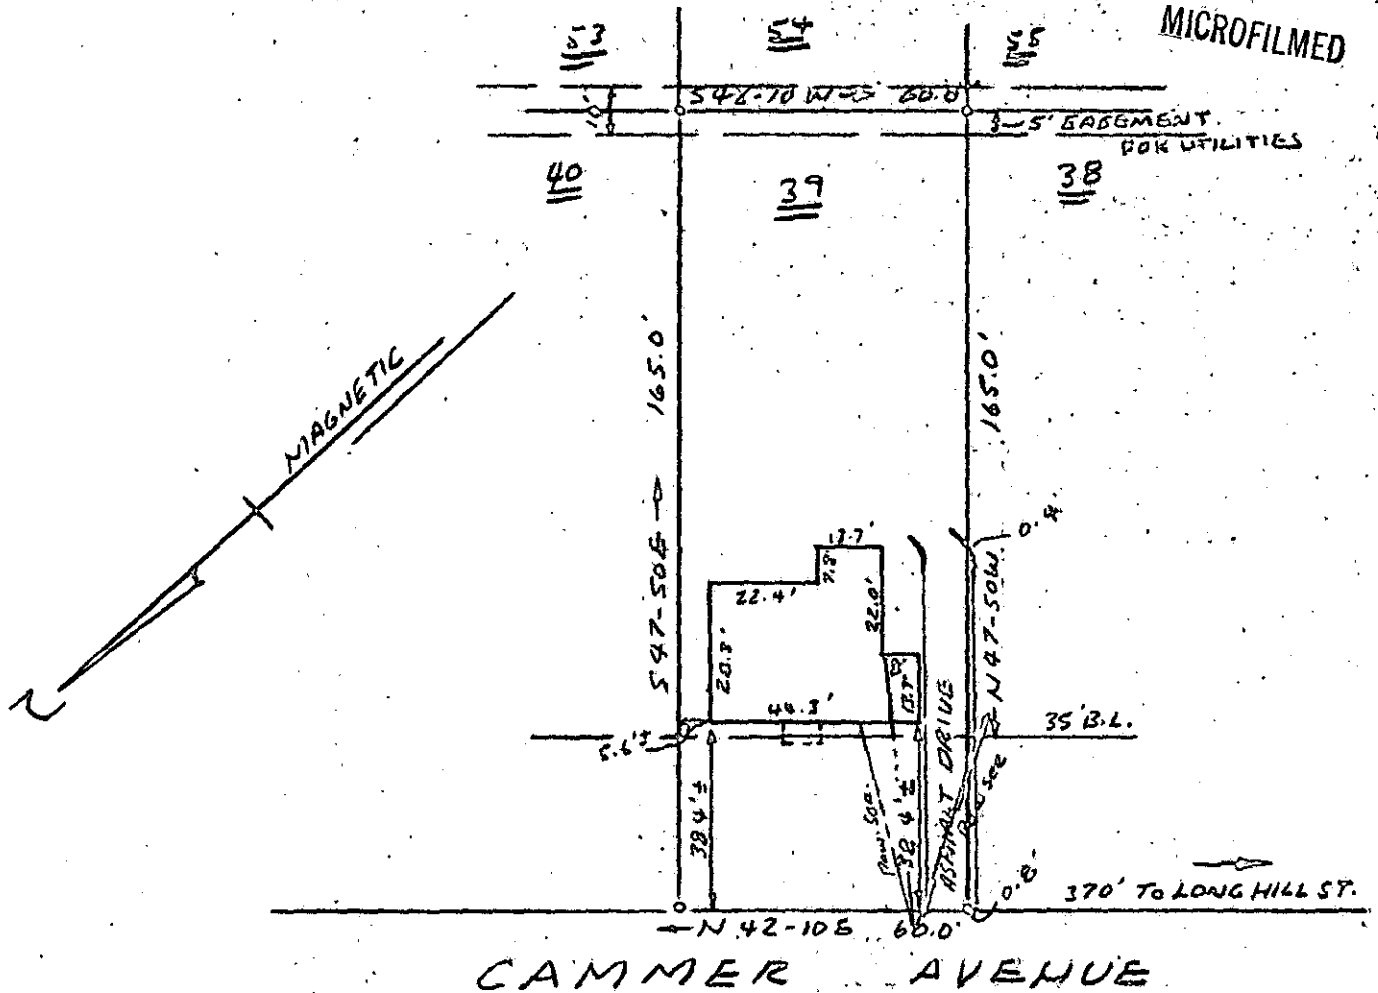

PROPERTY OF
DAVID A. HOOPER &
DELORES W. HOOPER
GREENVILLE, S.C.
JAN 29, 1976 SCALE: 1" = 40'

This is to certify that on January 29, 1976, I surveyed the property shown on this plat, known as Lot No. 39 of Augusta Road Hills as shown on a plat recorded in the RMC Office for Greenville Co. in Plat Book L at pages 56 & 57, and that the property lines, walls and building are as shown hereon, and that the building located on said lot does not project nor encroach on adjacent streets or property, and that no adjacent walls or buildings project nor encroach on said lot, and that no utility lines cross this lot except as may be shown hereon.

Survey by Campbell & Clarkson Surveyor, Inc:

SOUTH CAROLINA
 REGISTERED
 R. [Signature]
 S.C.R.E.B. No. 4678

19419

✓ 5Q-49

R.M.C.
 DONNIE S. TANKERSLEY
 JAN 30 10 34 AM '76
 GREENVILLE CO. S.C.
 FILED

RECORDING FEE
 PAID \$ 1.00

JAN 30 1976