


MICROFILMED

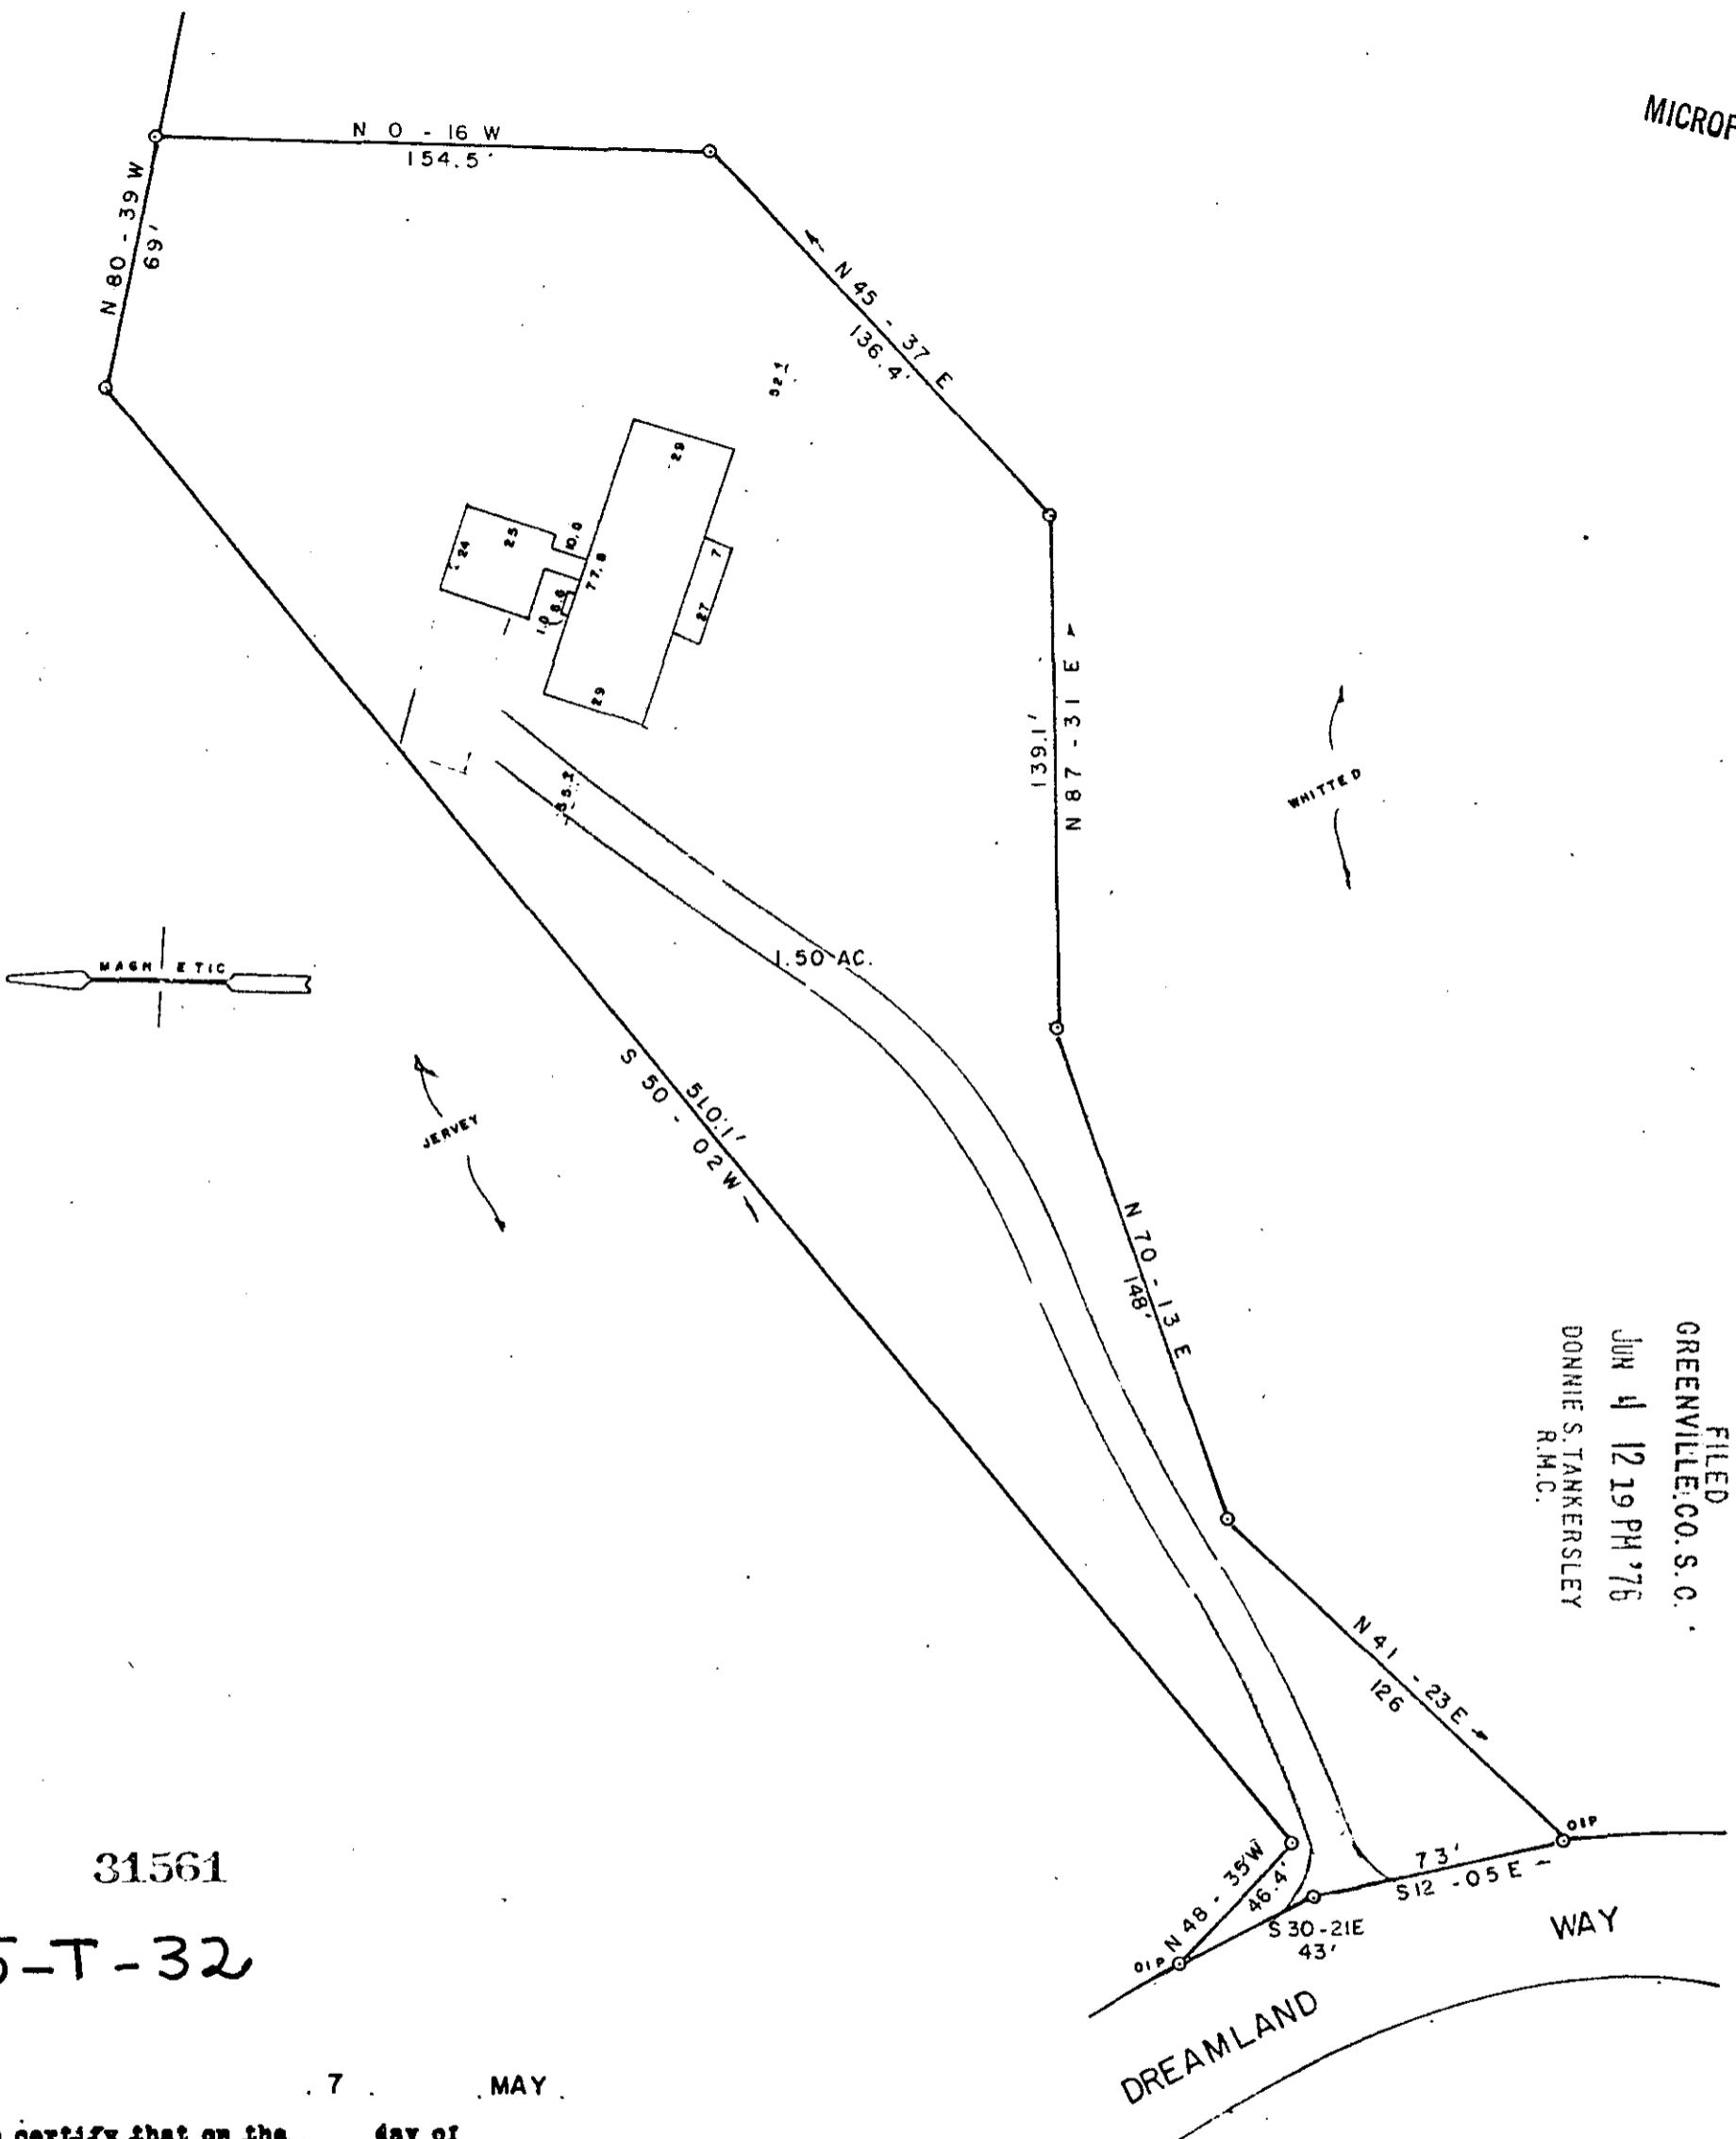


FILED  
 GREENVILLE CO. S.C.  
 JUN 4 12 19 PM '76  
 DONNIE S. TANKERSLEY  
 R.M.C.

31561

✓ 5-T-32

1976 . 7 . MAY .  
 This is to certify that on the 4th day of  
 1976, I surveyed the property shown on this  
 plat, being  
 326-27

recorded in Plat Book  
 of the R.M.C. Office for Greenville Coun-  
 ty, S. C., and that the property lines, walls and  
 buildings are as shown hereon; that the buildings  
 located on said lot do not encroach or project on  
 adjacent streets or property; and that no adjacent  
 buildings or walls encroach or project on said  
 premises, and that no utility lines cross this  
 property.

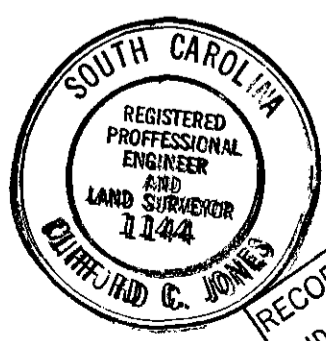

RECORDING FEE  
 PAID \$ 2.00

PROPERTY OF  
**PAULINE H. WHITTED &**  
**JACK R. WHITTED**  
 GREENVILLE COUNTY, S.C.  
 SCALE 1" = 50'  
 MAY 7, 1976