

AREA 11.10 ACRES

MICROFILMED


This is to certify that on July 23, 1976 I surveyed the property shown on this plat, known as Property of William T. Merritt and Jeanine L. Merritt, recorded in the RMC Office of Greenville County in Deed Book 951 on Page 456, and that the property lines, walls and buildings are as shown hereon; that the buildings located on said property do not encroach or project on adjacent streets or property, and that no adjacent walls or buildings encroach or project on said premises, and that no utility lines cross this property except as shown hereon.

*James R. Freeland*  
James R. Freeland RLS & PE 4781

2750

15-T-50

GREENVILLE CO. S.C.  
FILED  
JUL 28 2 21 PM '76  
DONNIE S. TANKERSLEY  
R.M.C.

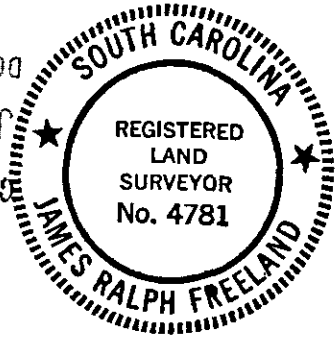

RECORDING FEE  
PAID \$ 2.00

|  |              |                           |
|--|--------------|---------------------------|
| STATE OF SOUTH CAROLINA<br>COUNTY OF GREENVILLE              |              |                           |
| SCALE: 1" = 100'   | APPROVED BY: | DRAWN BY E.L.             |
| DATE: 7-23-76  |              | REVISED                   |
| PROPERTY OF<br>CARROLL WAYNE STEWART &<br>ENYLAND D. STEWART |              |                           |
| FREELAND & ASSOC.<br>GREENVILLE, S.C.                        |              | DRAWING NUMBER<br>76-1073 |