
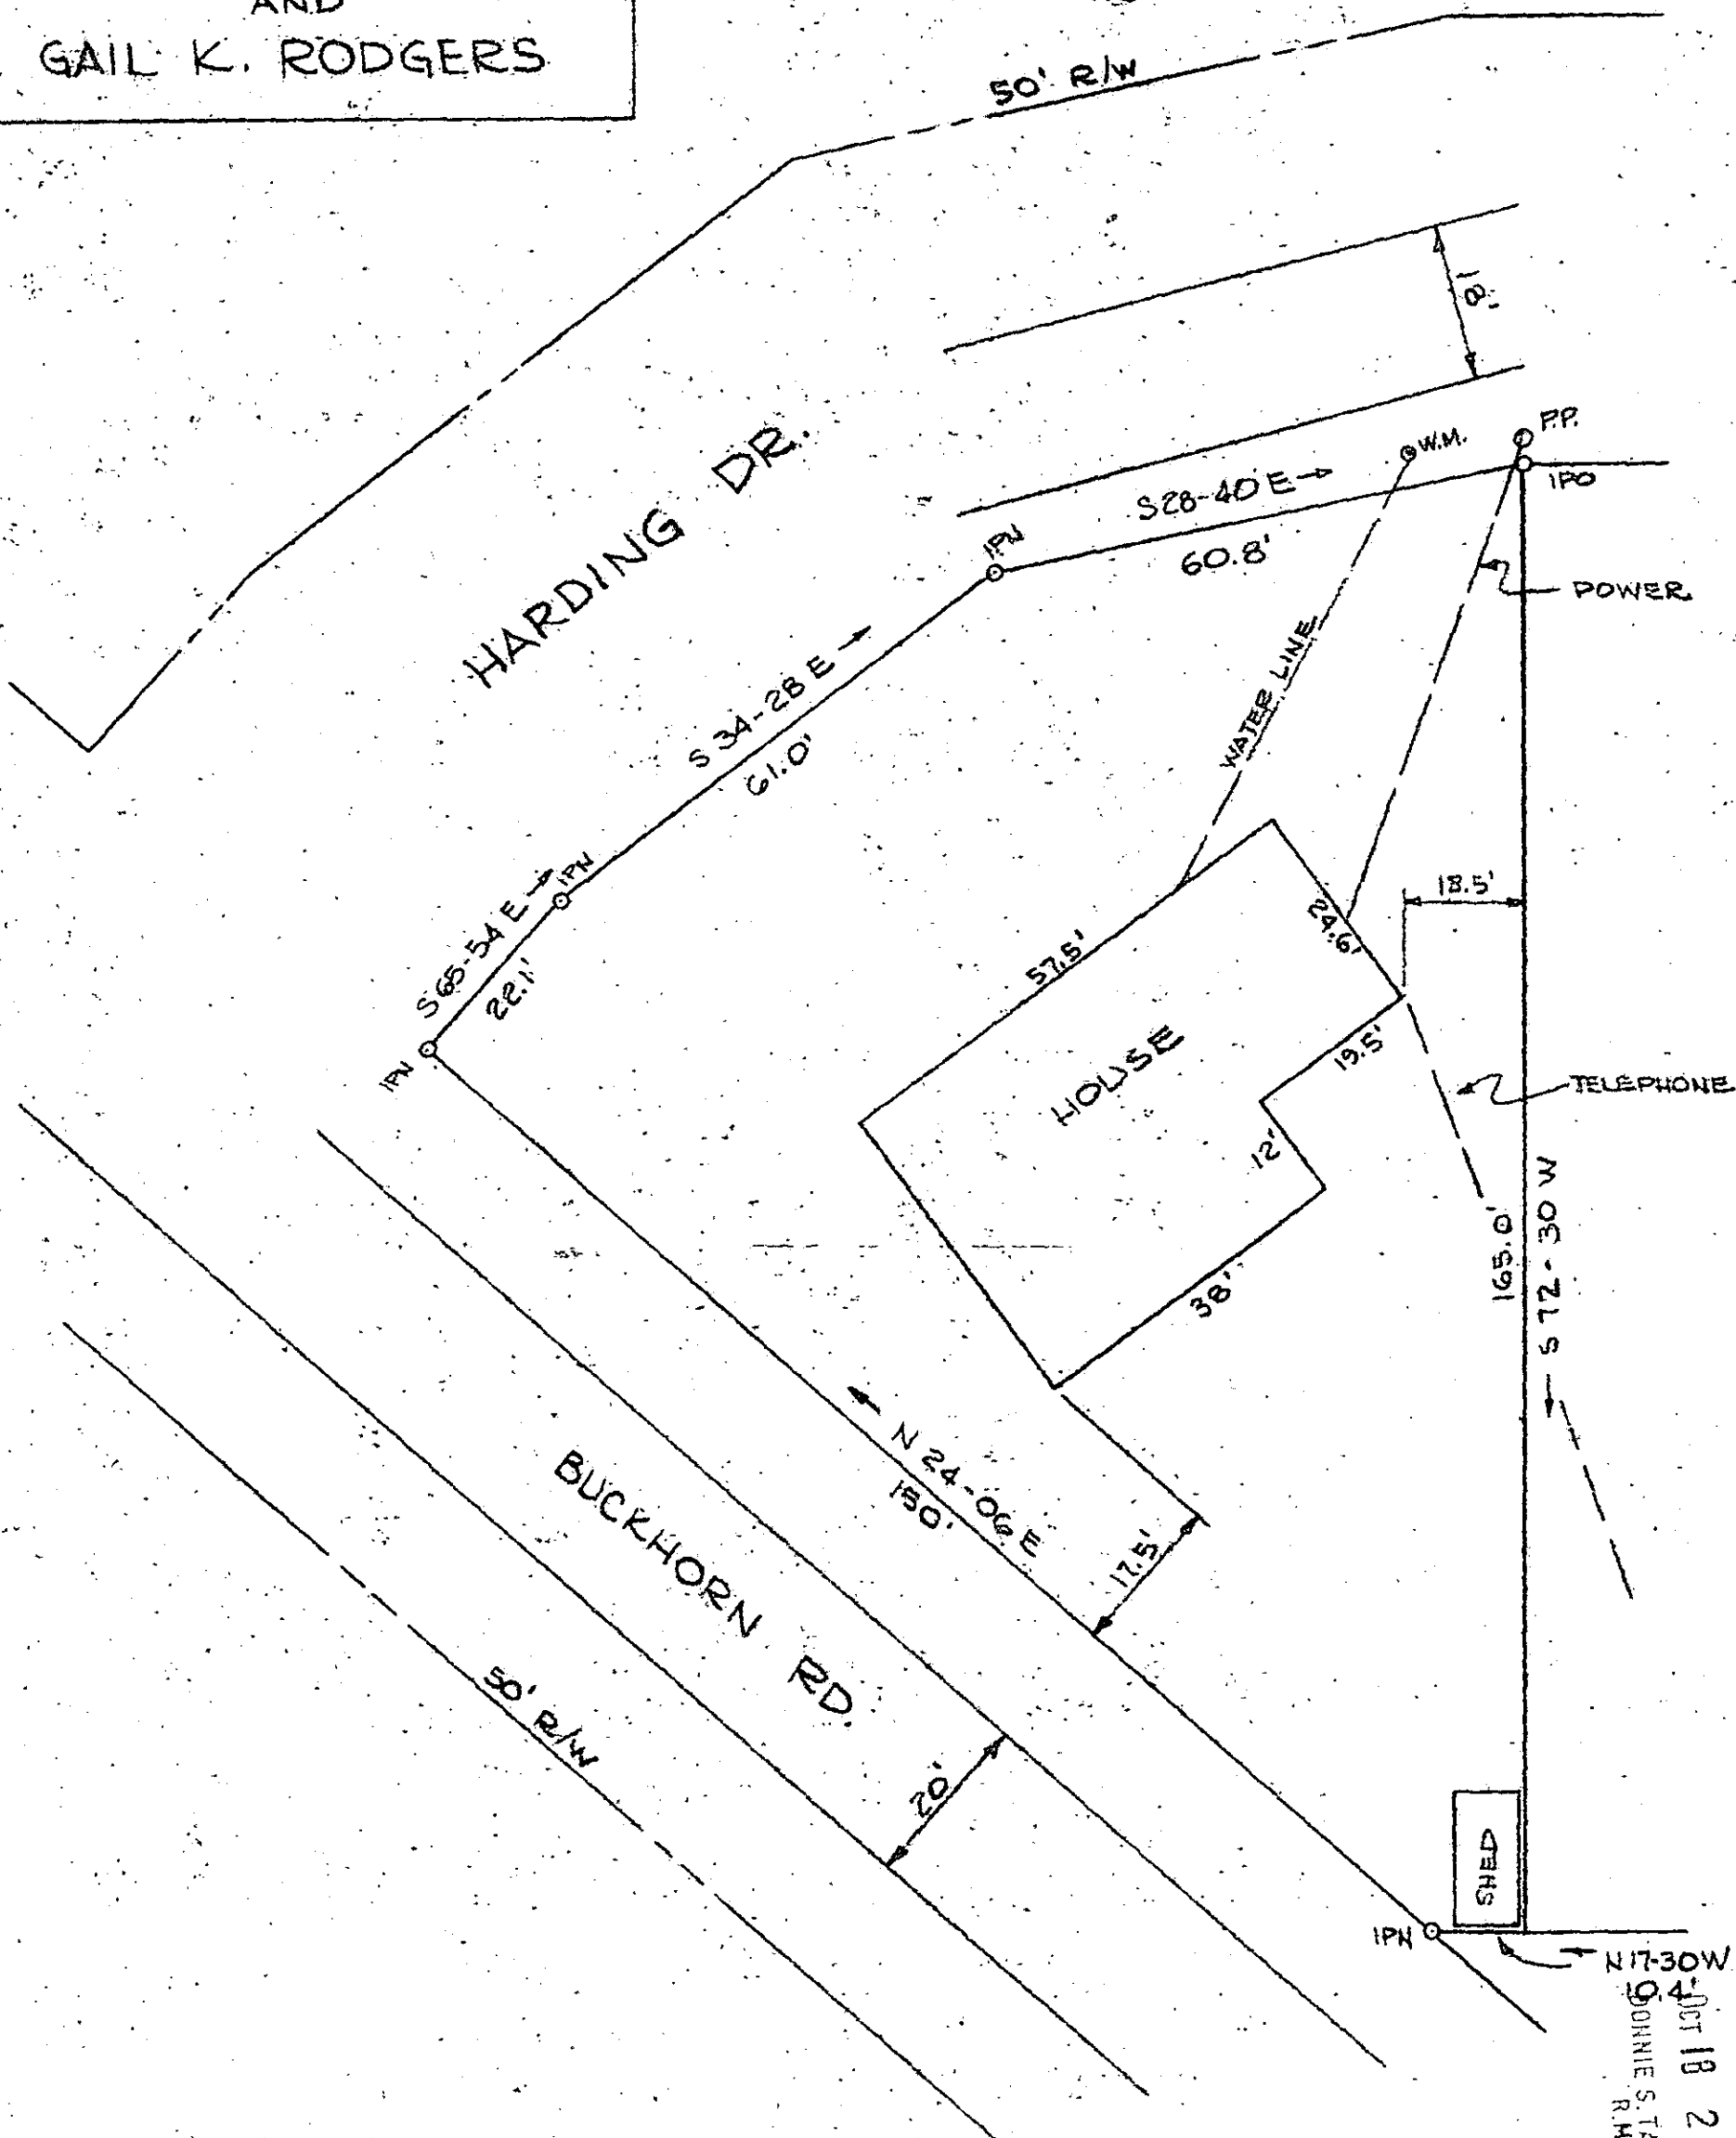


MICROFILMED

PROPERTY OF  
STEVEN M. RODGERS  
AND  
GAIL K. RODGERS

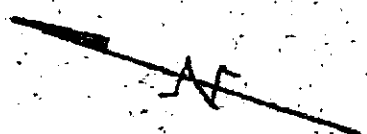


8  
28  
18 M  
200 M

This is to certify that the above property shown on this plat is known as Lot 1, Buckhorn Village, and recorded in the Greenville County R.M.C. Office in Deed Book 801, page 277; that the property lines, walls and buildings exist as shown hereon; that the buildings located on the property do not encroach or project on adjacent property and that utility lines cross this property as shown.

*Kenneth J. Gould* Name 4035 S.C. Reg. No. 10-14-76 Date 10674 15-T-89

ARBOR ENGINEERING			
RHF	1" = 20'	10/7/76	76044
DRAWN:	SCALE:	DATE:	JOB NO.

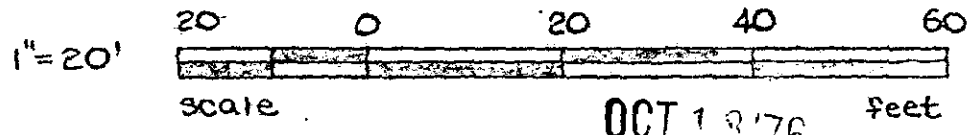

FILED  
GREENVILLE-00-5-0  
OCT 18 2 00 PM '76  
JOHNIE S. TANKERSLEY  
R.M.C.