


MICROFILMED

81-18

THIS PLAT IS NOT A SUBDIVISION
AS DEFINED BY THE GREENVILLE
COUNTY SUBDIVISION REGULATIONS.

7/17/76
J. Clayton Stone
Secretary, or Director of
Planning,
Greenville County Planning Commission

BROOK BEND COURT

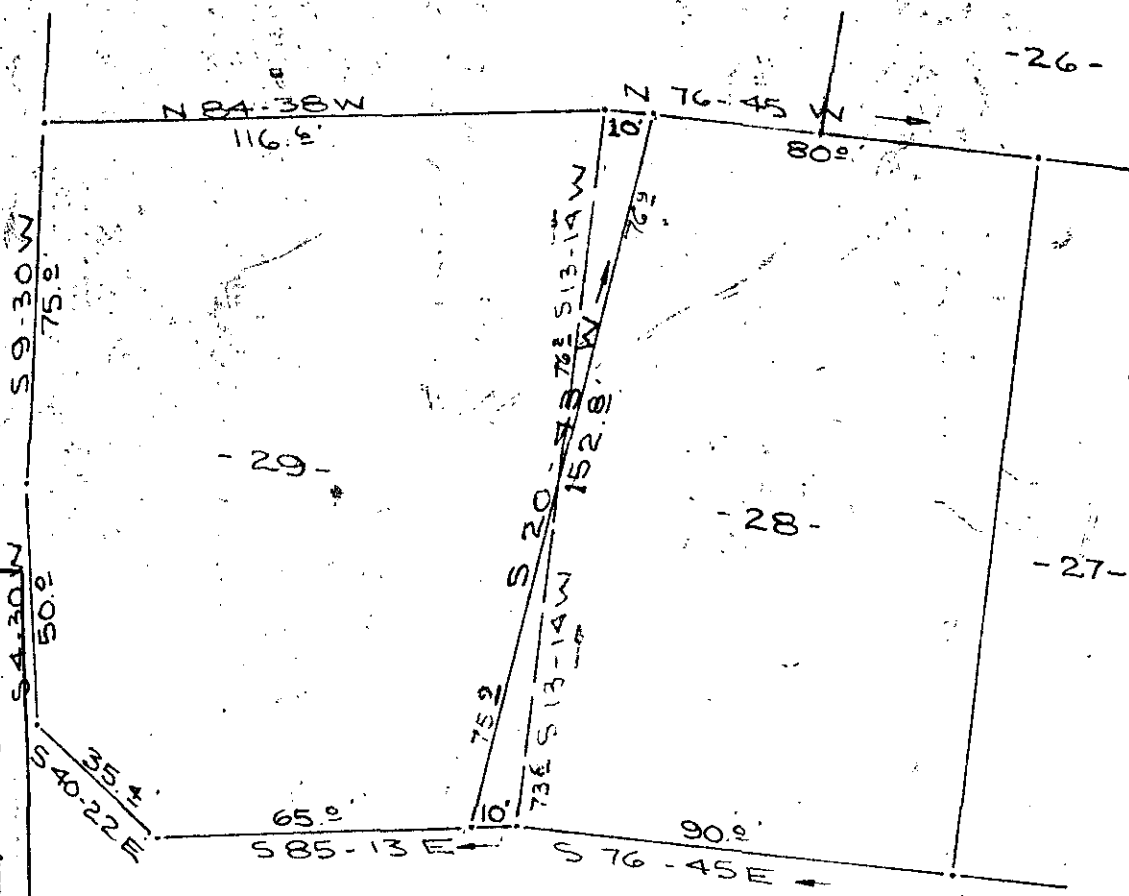

BROOK BEND ROAD

REVISION OF LOTS 28 & 29
HOLLY SPRINGS SUBDIVISION
NEAR MAULDIN GREENVILLE CO.
SOUTH CAROLINA
JUNE 28, 1972

FILED
GREENVILLE CO. S.C.
JUL 27 3 29 PM '76
DONNIE S. TANKERSLEY
R.M.C.

NOTE: PLAT OF HOLLY SPRINGS RECORDED PLAT BOOK 4N, PAGE 5
R.M.C. OFFICE, GREENVILLE CO.

W.R. WILLIAMS, JR R.L.S.#3979

RECORDING FEE
PAID \$ / .00

SCALE 1"=40'

2597

35-V-10