


FILED
GREENVILLE CO. S. C.

BLOCK BOOK REF:
T.B-4-9

Nov 22 10 52 AM '76
DONNIE S. TANKERSLEY
R.M.C.

NOTE: Improvements on this lot are not in a flood hazard area.

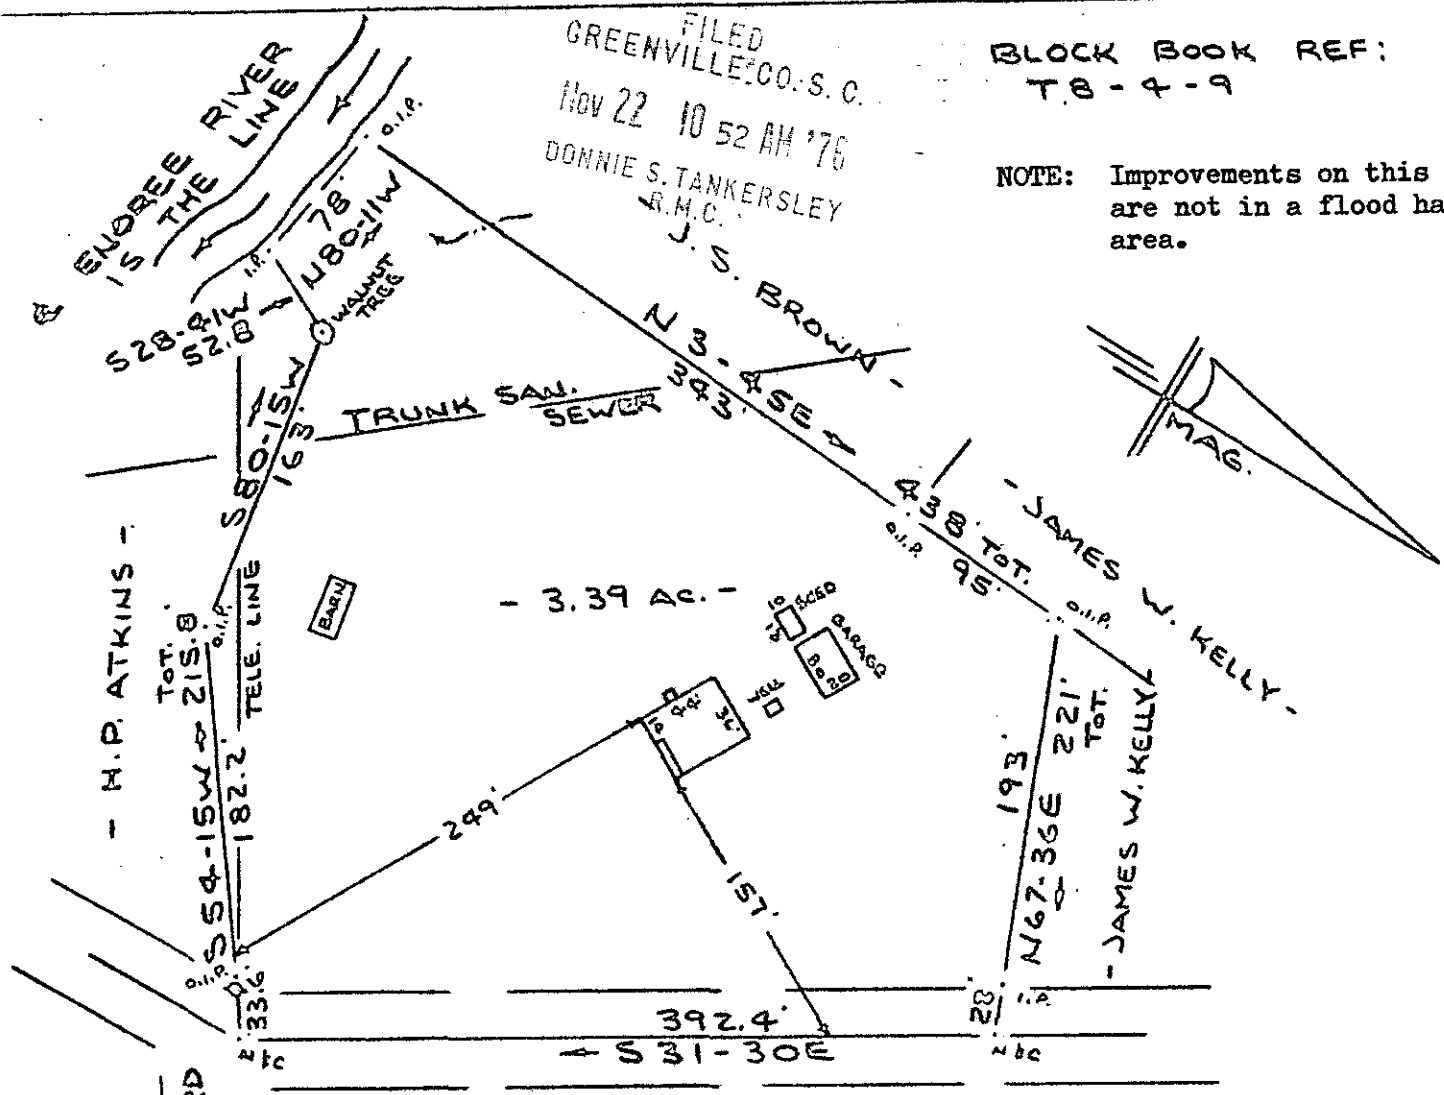


OLD TAYLORS BRIDGE ROAD
WATER & SEWER IN ST. R/W

PROPERTY OF
LOUISE M. MORAGNE
NEAR GREENVILLE, S. C.
SCALE 1"=100' 2 NOV 1976

This is to certify that on the 2nd day of November 1976, I surveyed the property shown on this plat, being known as 3.39 acres on plat of PROPERTY OF LOUISE M. MORAGNE and recorded in the REC Office Greenville County, S. C., in Plat Book at Page ; and that the property lines, walls and buildings are as shown hereon, and that the walls and buildings located on said lot do not encroach or project on adjacent street or property, and that no adjacent walls or buildings encroach or project on said premises, and no power lines cross this property except as shown hereon.

R. B. Bruco
R. B. Bruco, RLS #1952

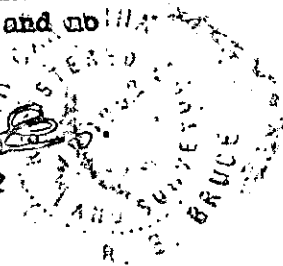

✓ 5-W-97 14095

NOV 22 1976

CAROLINA SURVEYING CO.
112 Manly St.
Greenville, S. C.

MICROFILMED

2662... 20M

1.00 AS

190/35

T.B-4-9