


- FAIRWAY FORD, INC. -

- FAIRWAY FORD, INC. -

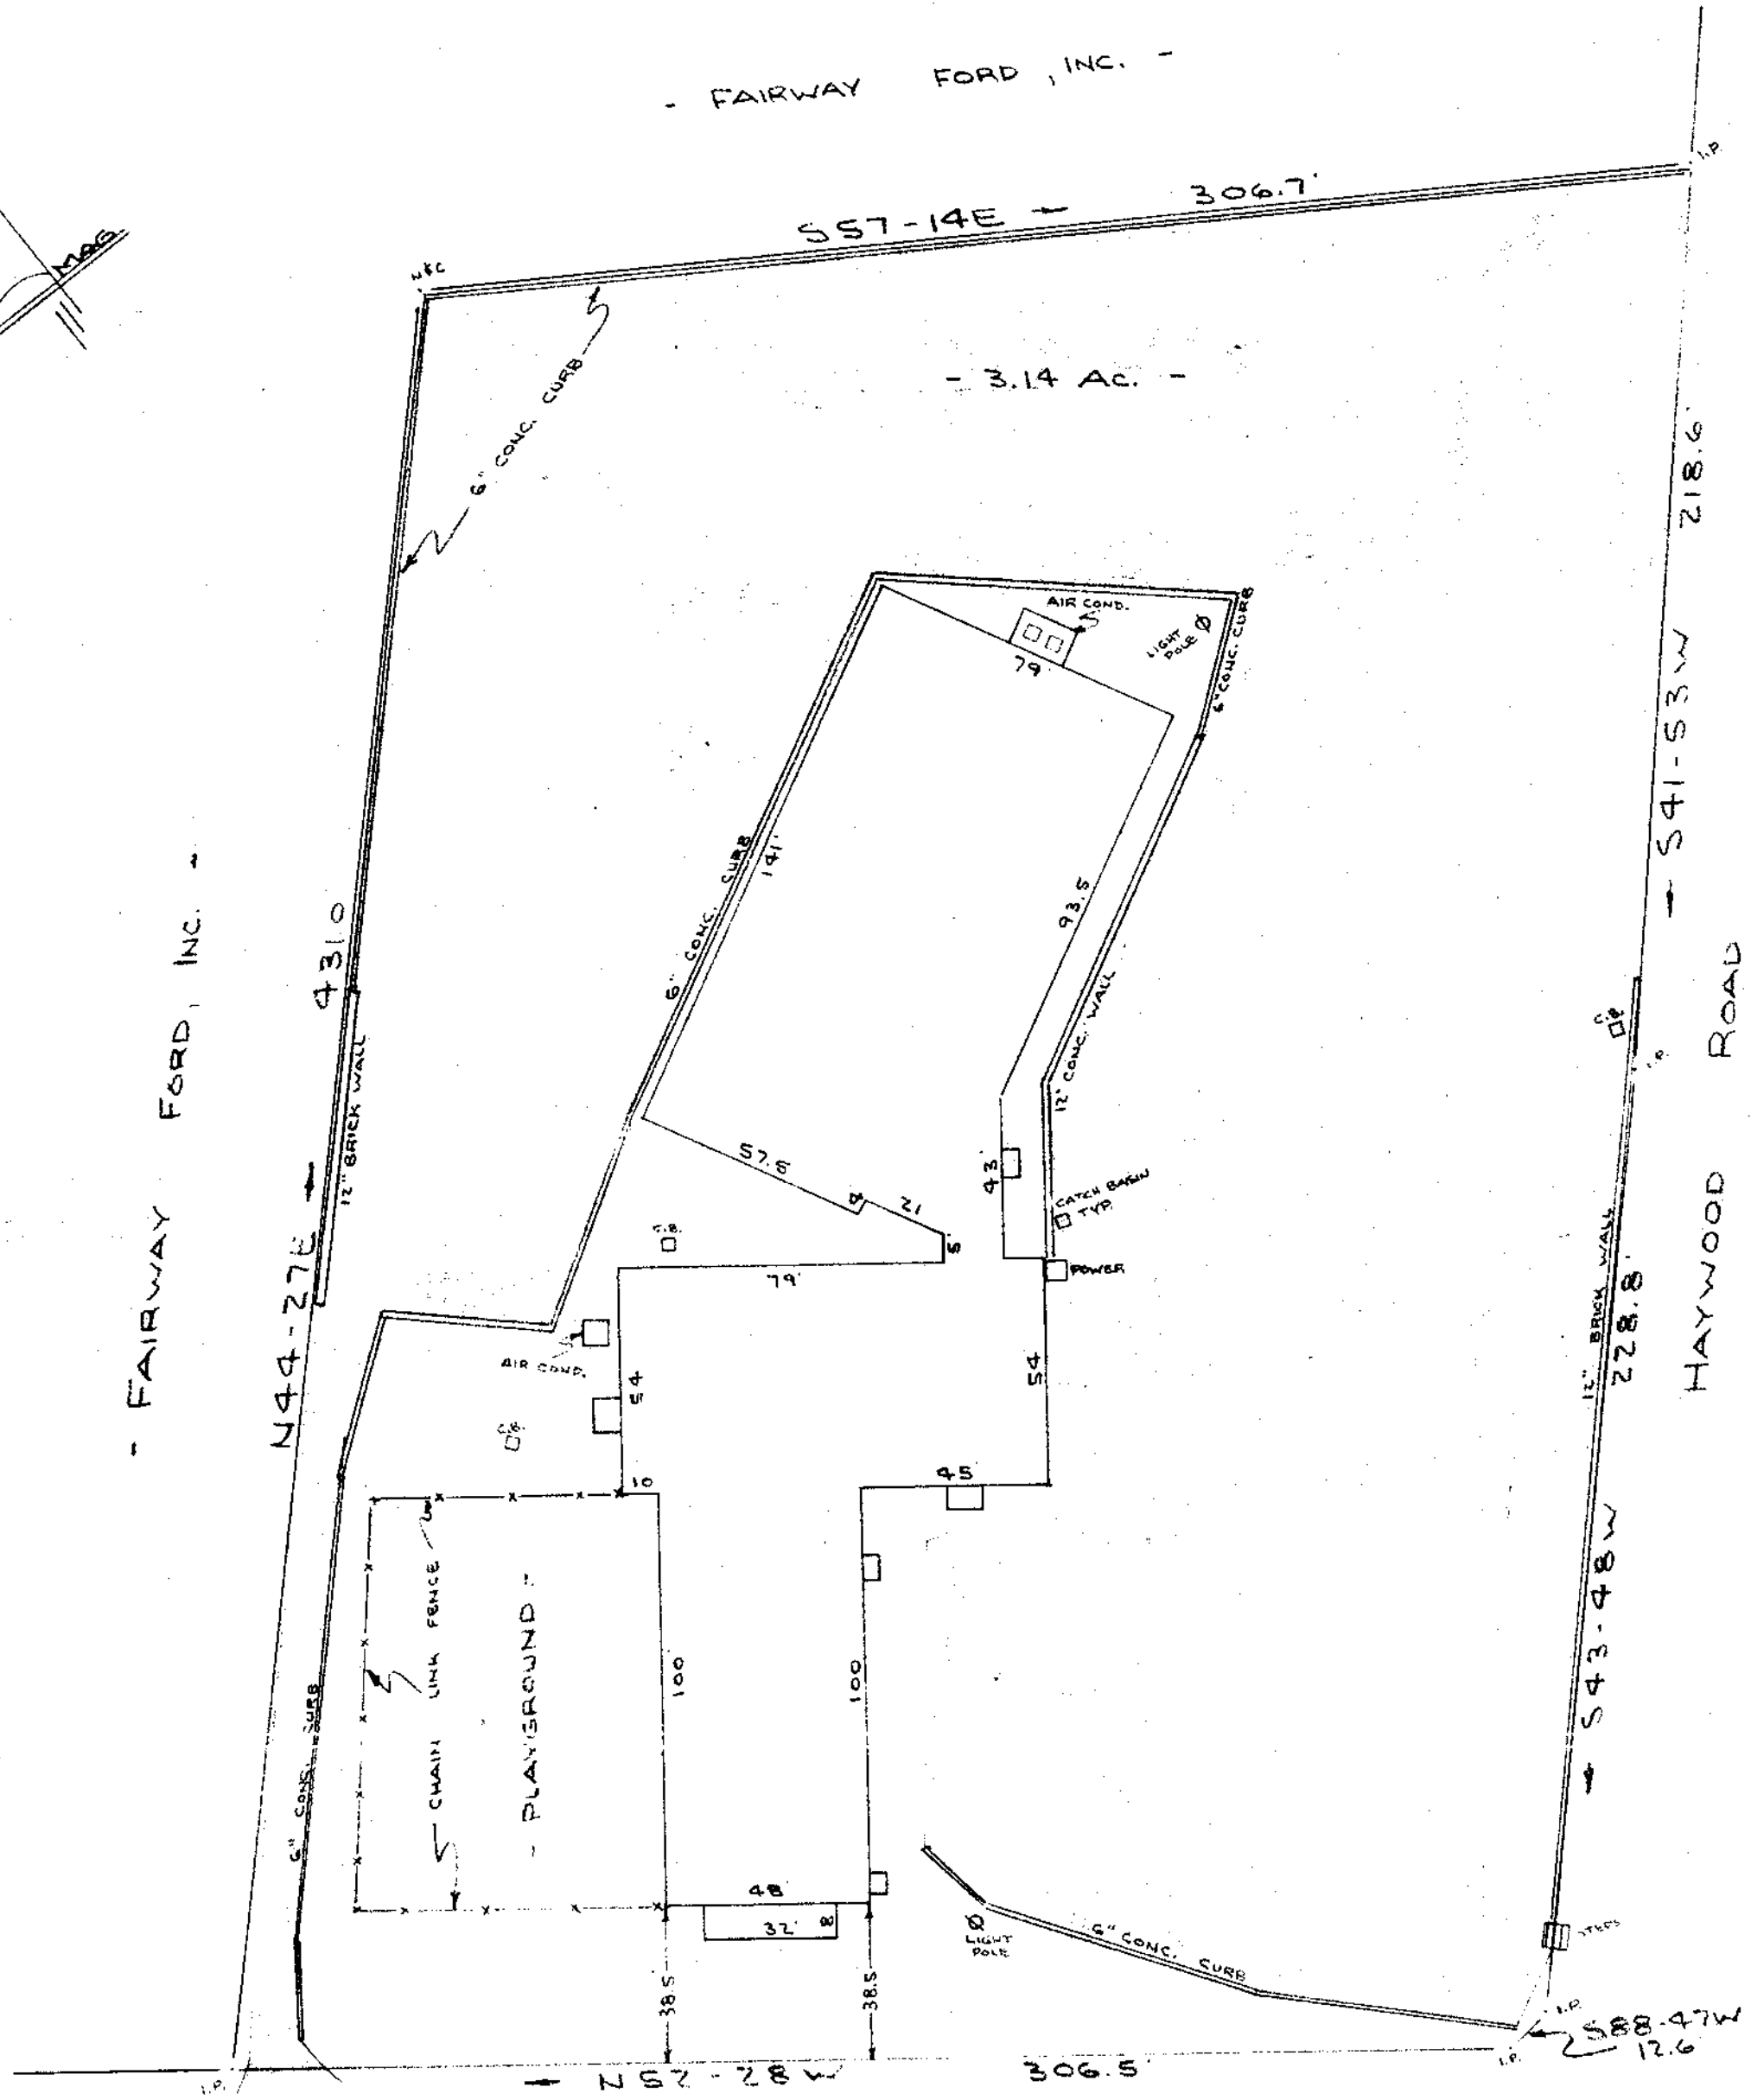

HAYWOOD ROAD

LAURENS ROAD  
U. S. HIGHWAY 276

SURVEY FOR  
LAUREL BAPTIST CHURCH  
GREENVILLE, SOUTH CAROLINA  
SCALE 1" = 40' 25MAR1977

MICROFILMED

This is to certify that on the 25th day of March, 1977, I surveyed the property shown on this plat, being known as PROPERTY OF LAUREL BAPTIST CHURCH recorded in the R/W Office Greenville County, S. C., in Plat Book "JJJ" at Page 35 also shown as PROPERTY OF LAUREL BAPTIST CHURCH recorded in Plat Book 5-y at Page 75; and that the property lines, walls and buildings are as shown hereon, and that the walls and buildings located on said lot do not encroach or project on adjacent street or property, and that no adjacent walls or buildings encroach or project on said premises, and no power lines cross this property except as shown hereon.

R. B. Bruce  
R. B. Bruce, R.S. 2152

FILED  
GREENVILLE CO. S. C.  
APR 4 2 19 PM '77  
DONNIE S. TANKERSLEY  
R.M.C.

26407

CAROLINA SURVEYING CO  
112 MANLY ST.  
GREENVILLE, S. C.

5-y-75

APR 4 1977

263-2-1

1 7 35 AM 4M

2.00 AM

8/64