


FILED
GREENVILLE CO. S.C.
MAY 11 9 42 AM '77
DONNIE S. TANKERSLEY
R.M.C.



MAY 11 1977 30548

THIS IS TO CERTIFY THAT ON THE 21ST DAY OF APRIL 1977 I DID LOCATE THE REVCO BUILDING AS SHOWN ABOVE, AND IT DOES NOT ENCROACH ON ANY ADJACENT PROPERTY. ALL OTHER INFORMATION TAKEN FROM A SURVEY BY C.C. JONES ENG. DATED DEC. 16, 1972.

5-Y-98

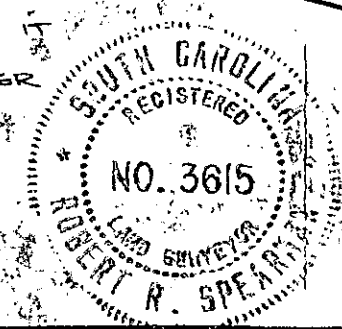

ROBERT R. SPEARMAN
Registered Surveyor 3615
Post Office Box 6
Easley, South Carolina 29640



TITLE	PLAT FOR VALLEY COMMERCIAL PROPERTIES		
STATE	SOUTH CAROLINA	COUNTY	GREENVILLE
SCALE	1" = 100'	DATE	APRIL 26, 1977
REF. NO.			

MICROFILMED 200 AS 8357 11M