
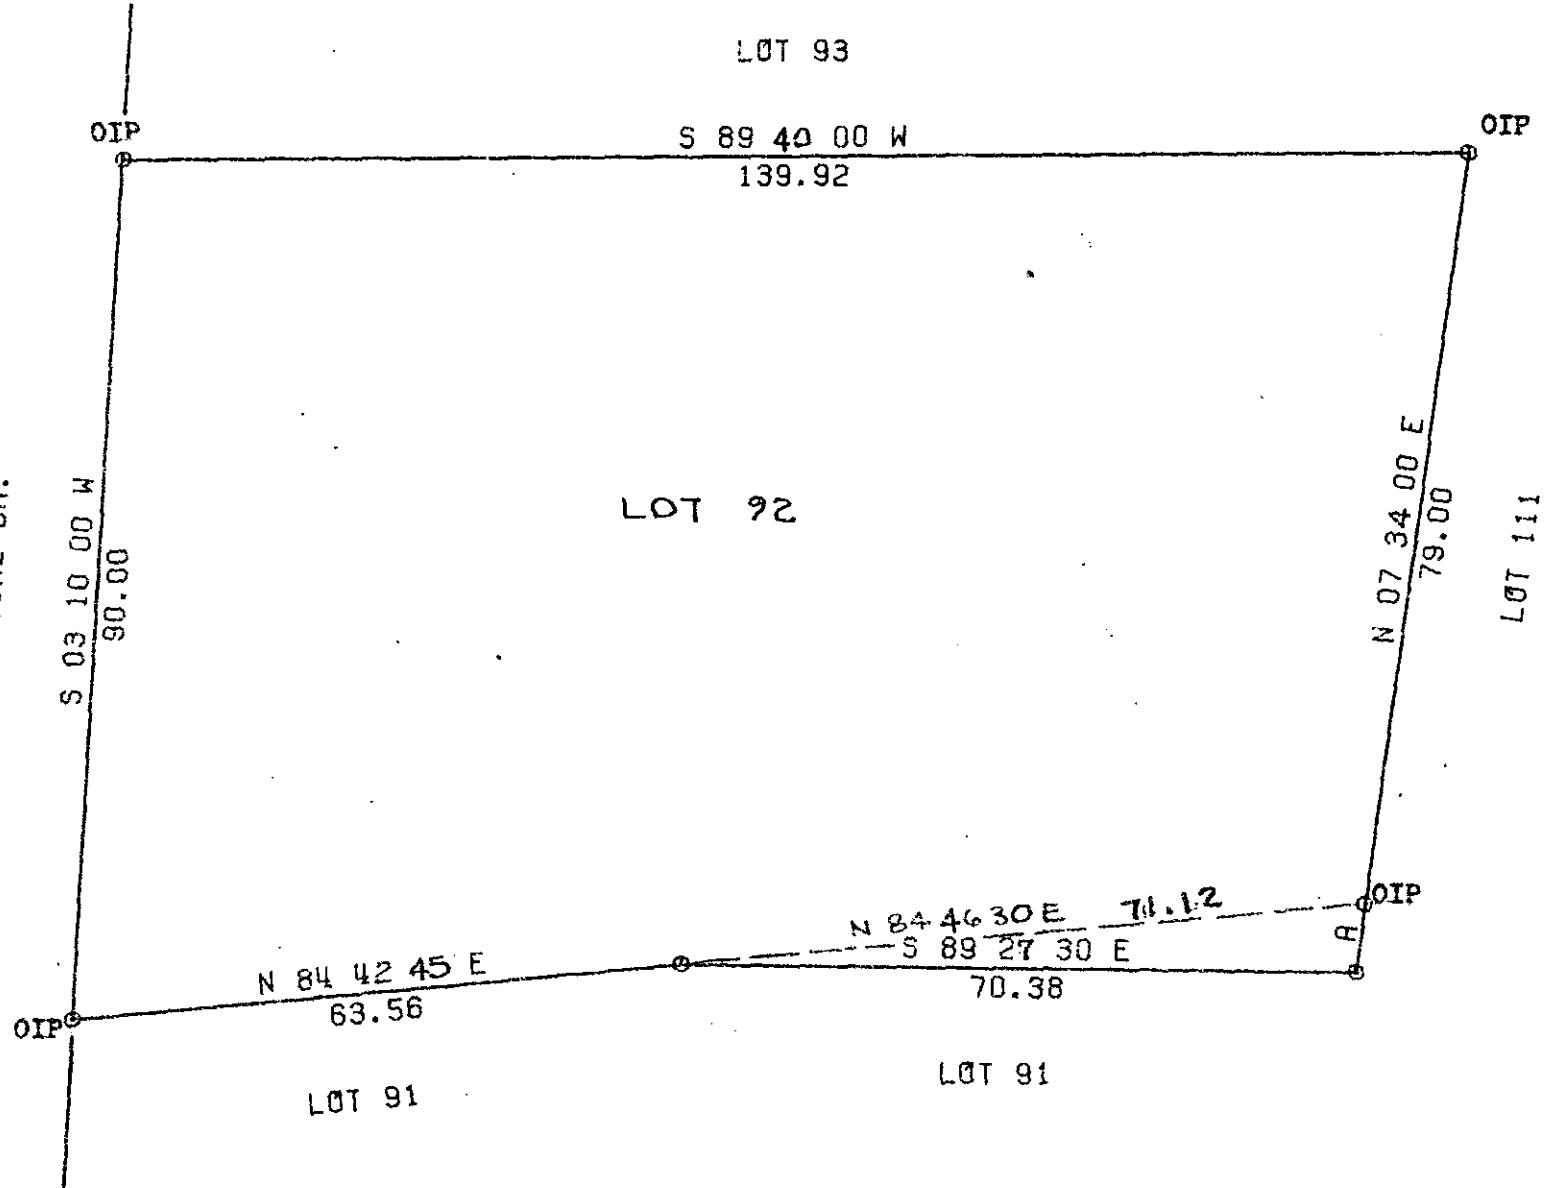


MICROFILMED

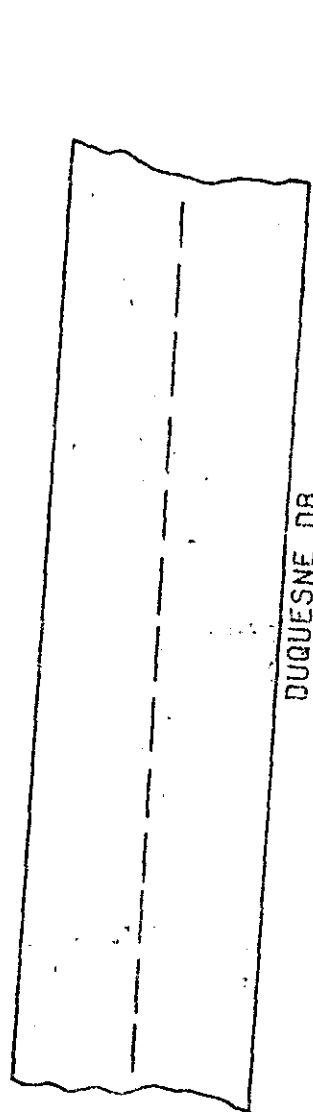

LINE	BEARING	LENGTH
A	N 07 34.00 E	7.20

FILED
 GREENVILLE CO. S.C.
 MAY 12 3 24 PM '77
 DONNIE S. TANKERSLEY -
 R.M.C.

ARBOR ENGINEERING

ACREAGE - 0.269
 PLAT OF UNBALANCED TRAVERSE
 PRECISION OF FIELD SURVEY - 1:3490
 SCALE 1 IN. = 20 FT.

DATE: MAY 3, 1977
 STATE OF SOUTH CAROLINA
 COUNTY OF GREENVILLE
 LOT # 92, CANE BRAKE SUBDIVISION

PLAT PREPARED FOR
 WALTER E. SCRUGGS JR.
 GAIL J. SCRUGGS

ACCURACY CHECKED
 R. Jay Cooper
 MAY 12 1977
 R. JAY COOPER, L.S. No. 4882
 ROBERT W. FRUSH, L.S. No. 5716
 8 5 17 JAN 688 PEN
 2.00 M4

NOTE: ALL CORNERS MARKED BY IRON PINS UNLESS OTHERWISE INDICATED

30775 ✓

5-y-99