

FILED  
GREENVILLE, CO. S.C.

MAR 5 3 56 PM '79  
DONNIE S. TANKERSLEY  
R.M.D.

SADDLE HORSE FARMS

HARNESSTRAIL

N 81-47 E 431' →

281

150'

5 1/2' 00'

39'

I.P.

M 27-25  
171.6'  
14.7'

N 83-35 E →

14.7'

0.94 Ac.

S 31 E M 12-2 N

138.5'

125'

R. C. AYERS

2.12 Ac.

V B-42 W 352.4'

L A K E

A Y E R S

R. C.

I.P. 7.9' back  
276.1'

573-40 W

414.6'

MAGNETIC

THIS PLAT IS NOT A SUBDIVISION  
AS DEFINED BY THE GREENVILLE  
COUNTY SUBDIVISION REGULATIONS.  
3/15/79  
Chairman, Secretary, or Director of  
Greenville County Planning Commission

*Donnie S. Tankersley*

25354

PROPERTY OF

TERRY LEE AYERS


NEAR GREENVILLE S.C.

SCALE 1"=100'

AUG. 31, 1976

C. O. RIDDLE - Reg. L.S. 1347 - Greenville, S.C.

Divided and plat revised 3/1/79

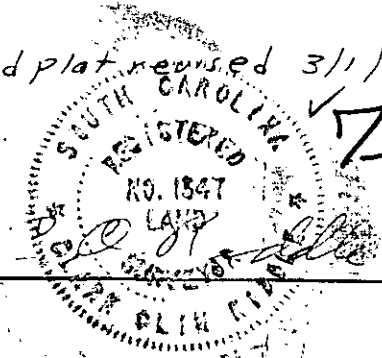

MICROFILMED

F.B. A-76

0010 1979 579 1382

I.C.C.I.