


MICROFILMED

FILED  
GREENVILLE, CO. S. C.  
MAR 19 2 23 PM '79  
DONNIE S. TANKERSLEY  
R.M.C.

ROSS ST.  
WATER IN ST. RSW

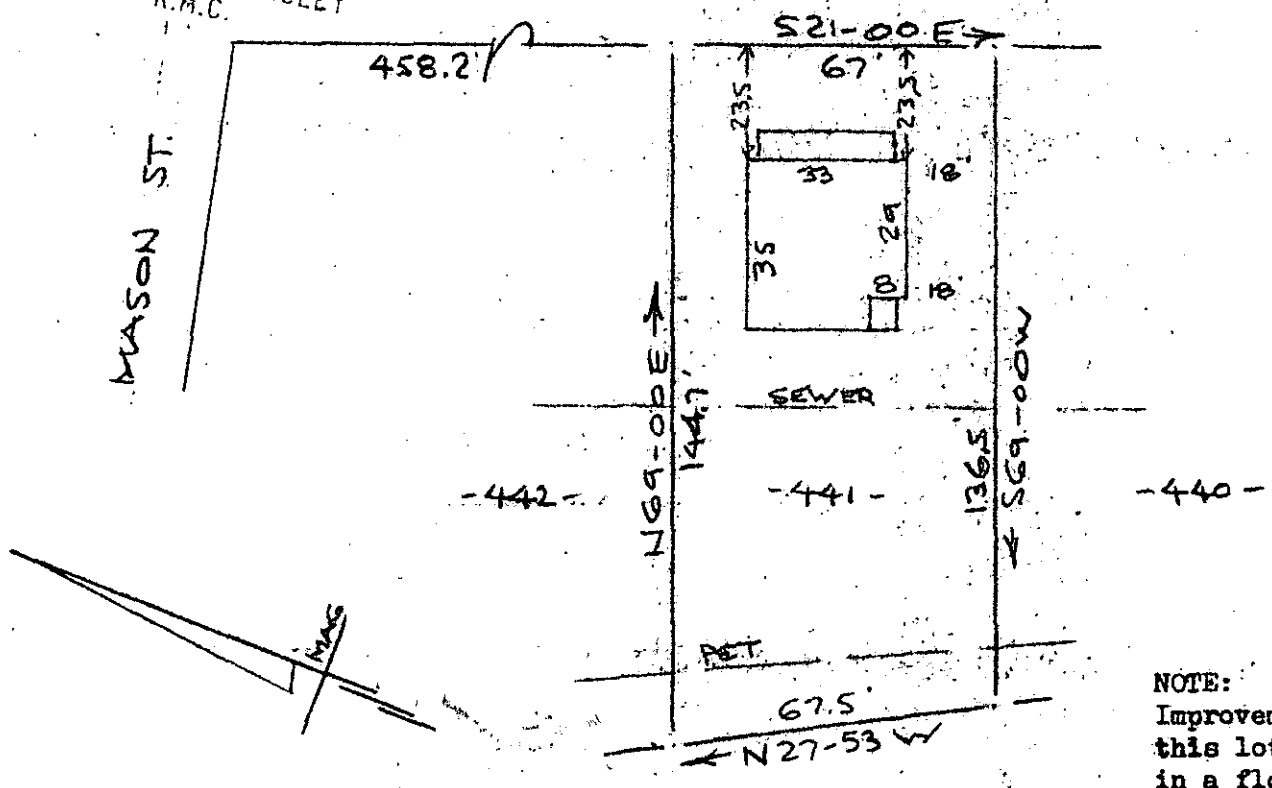

NOTE:  
Improvements on  
this lot are not  
in a flood hazard  
area.


PROPERTY OF  
ROBERT H. WYNNE JR  
NEAR GREENVILLE, S. C.  
SCALE: 1" = 40'  
8 MAR 1979

This is to certify that on the 8th day of March, 1979, I surveyed the property shown on this plat, being known as lot 441 on plat of SECTION 2 Abney Mills - Brandon and recorded in the RMC Office Greenville County, S. C., in Plat Book " QQ " at Pages 56 - 59; and that the property lines, walls and buildings are as shown hereon, and that the walls and buildings located on said lot do not encroach or project on adjacent street or property, and that no adjacent walls or buildings encroach or project on said premises, and no power lines cross this property except as shown hereon.

MAR 19 1979

7B-66

26805

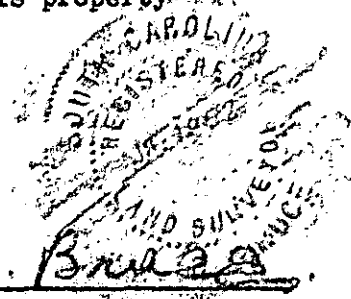

R. B. Bruce

CAROLINA SURVEYING CO.  
112 Manly St.  
Greenville, S. C.

R. B. Bruce, RLS #1952

GCTO -----3 MR19 79 852 1.00CI