

MICROFILMED


FILED  
GREENVILLE CO. S. C.

HAR 20 12 32 PM 1979  
DONNIE STARNER C.A.S.  
W.H.C. W.H.C.

CHARLESTON & W.H.C. CAROLINA RAILWAY  
N 51-30 E  

This is to certify that on March 15, 1979, I surveyed the property shown on this plat known as Ansley Bruce Property recorded in the RMC Office of Greenville County in Deed Book 1091 on Page 427, and that the property lines, walls, and buildings are as shown hereon; that the building located on said lot does not encroach or project on adjacent streets or property, and that no adjacent walls or buildings encroach or project on said premises, and that no utility lines cross this property except as shown hereon. This property is not located in a designated flood hazard area.

*James R. Freeland*  
James R. Freeland RLS & PE 4781

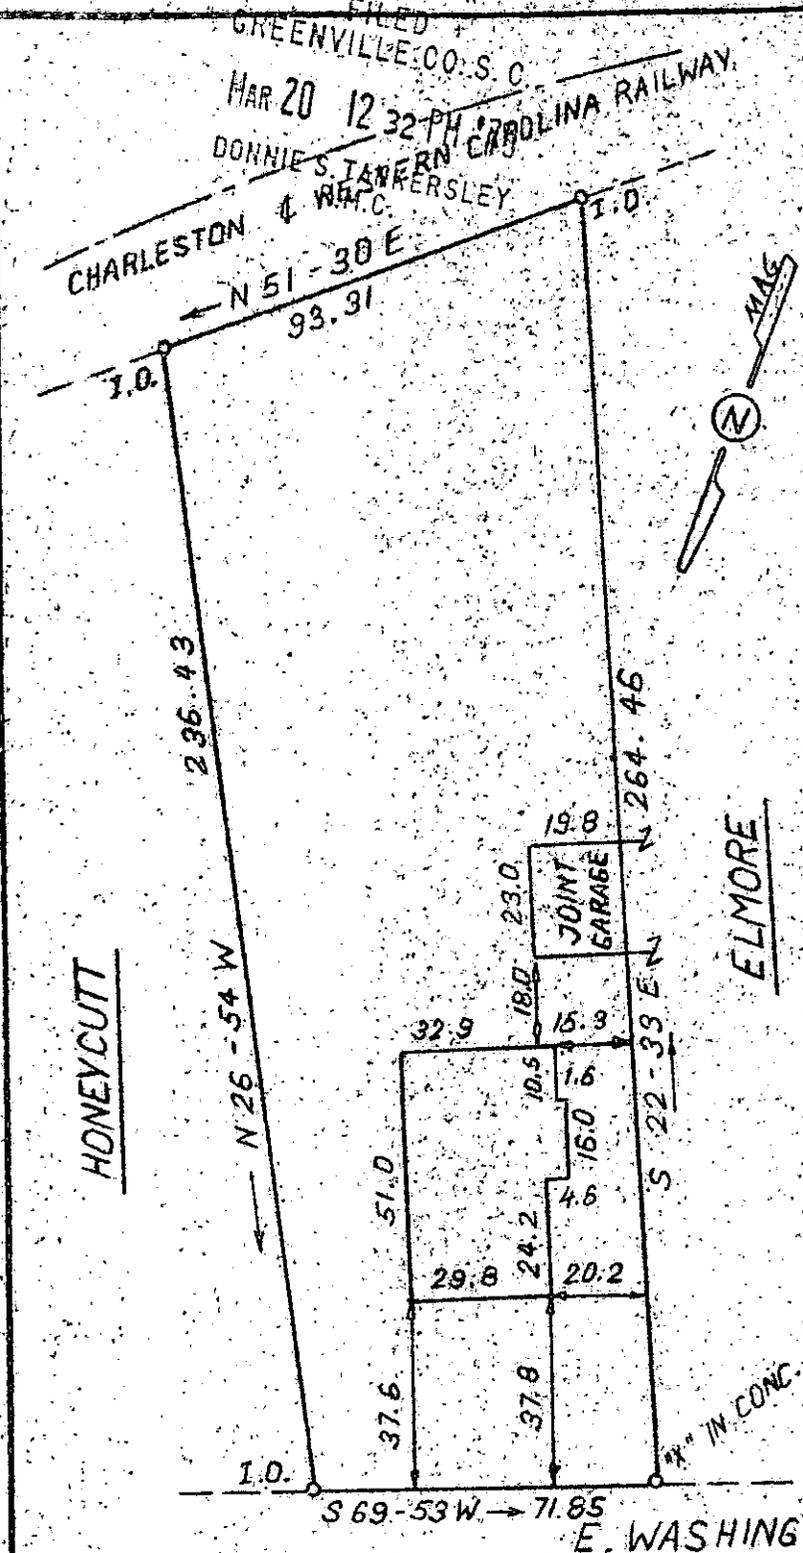

ELMORE

✓ 7-B-67

26873

STATE OF SOUTH CAROLINA  
GREENVILLE COUNTY

PROPERTY OF  
ANSLEY BRUCE JR.

FREELAND & ASSOCIATES  
Engineers • Land Surveyors

GREENVILLE, S. C.

SURVEY D.G.  
DRAWN B.R.  
CHECK W.H.C.  
SCALE 1" = 40"  
DATE MARCH 16, 79  
DWO. NO. 79-3030



4 0 7 5 2 0 6 1 0 0 1