MICROFILMED

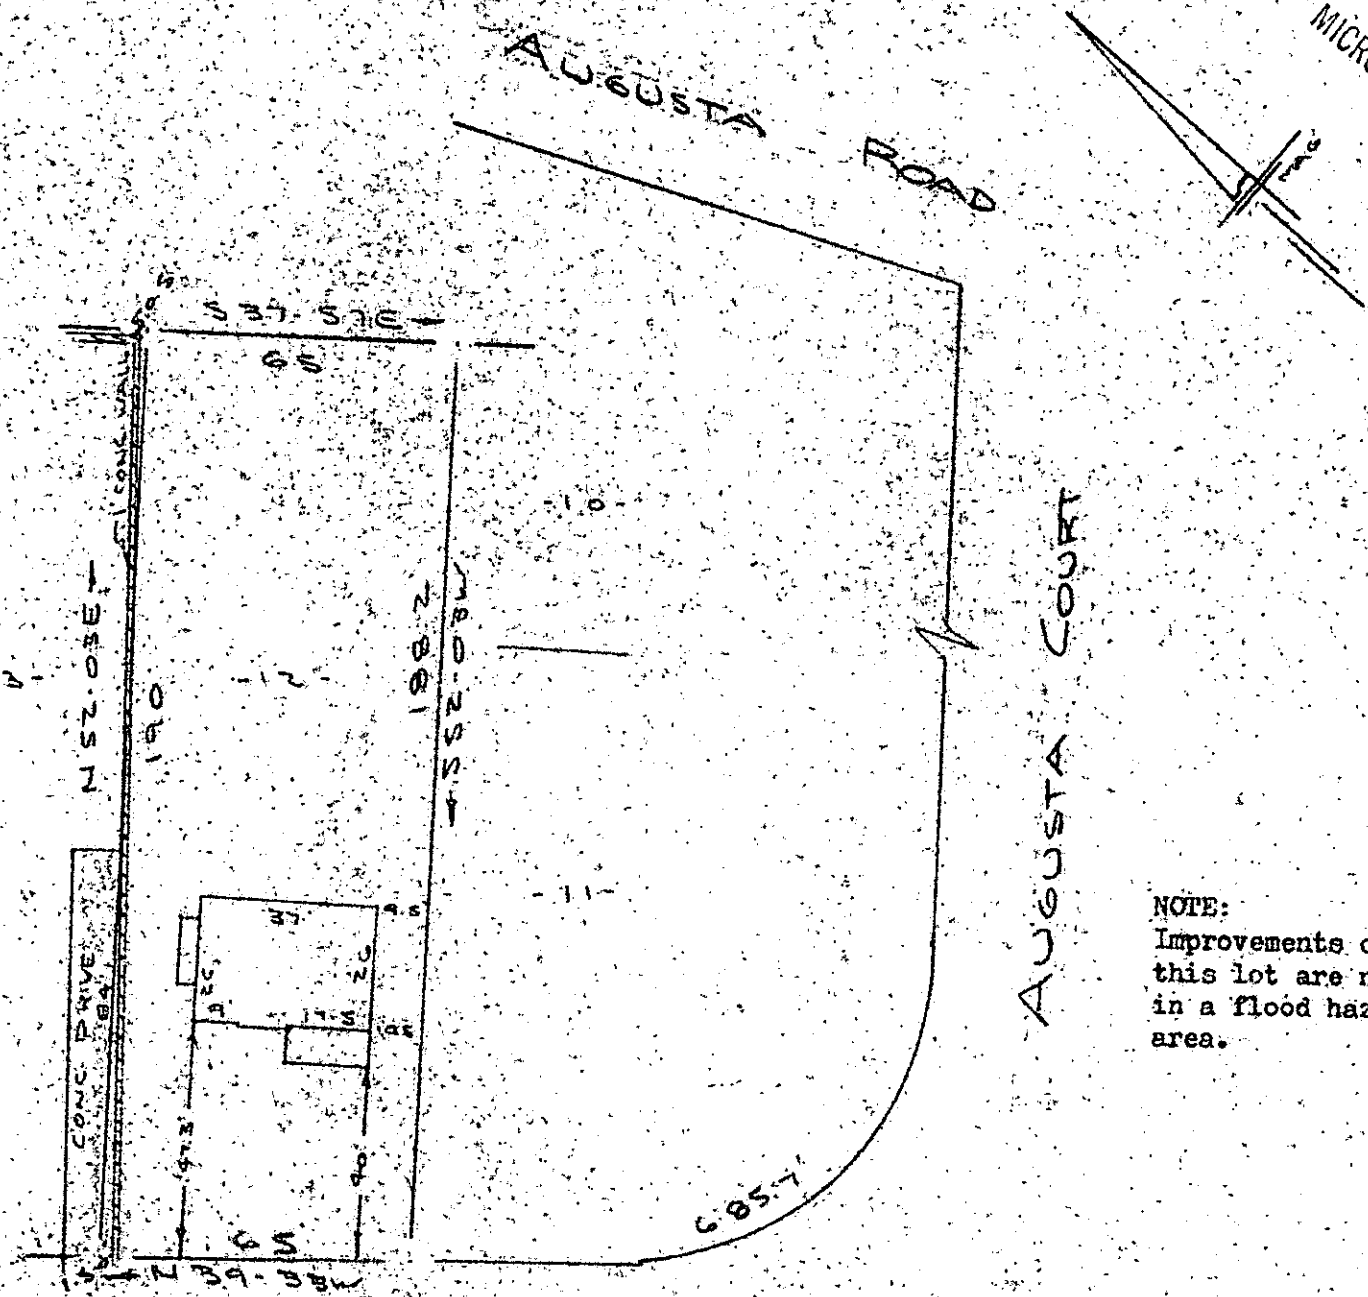

NOTE:
Improvements on this lot are not in a flood hazard area.

PROPERTY OF
RONALD S. CLEMENT
GREENVILLE, S.C.
SCALE 1" = 40' 21 MAY 1979

This is to certify that on the 21st day of May, 1979, I surveyed the property shown on this plat, being known as lot 12 on plat of BLOCK " A " AUGUSTA COURT and recorded in the " F " at Page 124; and that the property lines, walls and buildings are as shown hereon, and that the walls and buildings located on said lot do not encroach or project on adjacent street or property, and that no adjacent walls or buildings encroach or project on said premises, and no power lines cross this property except as shown hereon.

34256

DONNIE S. TANKERSLEY
R.M.C.
MAY 22 3 55 PM '79
GREENVILLE CO. S.C.
FILED

R. B. Bruce

R. B. Bruce, RLS #1952

CAROLINA SURVEYING CO.
112 Manly St.
Greenville, S. C.

MAY 22 1979

GCTO ——— 3 MY 22 79

570

1.00CI

√7-F-17

213 @ 23